

AS BUILT Plan of SAMPLE BARANGAY (1/28)

FTTH Symbols

LCP (1:8)

LCP (1:4)

NAP (1:8)

Future LCP (1:8)

Future NAP (1:8)

Future NAP (1:8), 2nd splitter for future DIGITEL/SMART Pole

PLDT Pole (Circular Conc.)

PLDT Pole (Wooden)

PT&T Pole

Manhole

Electric Pole (Conc. Square)

Electric Pole (Conc. Circular)

Electric Pole (Wooden)

Electric Pole (Steel)

LOOP 5m (FOR FUTURE LCP /NAP/BRANCHING) Grounding System

Extended messenger wire

No Pole Togs

Transformer

Danger

Don't Attach

Occupied House Number

Occupied House no number

Vacant Lot Number

Vacant Lot no number

Existing SIDE GUY

Proposed DOWN SIDE GUY

Proposed SIDEWALK, SIDE GUY WITH ANCHOR

FOC (Aerial Installation)

FOC (Underground Installation)

Proposed Pole

SAMPLE PROVINCE: BOHOL
SAMPLE TOWN/CITY: DAUIS
SAMPLE BARANGAY: SAN ISIDRO

SNAP ID: -----
NOTES: PCN:-----

TOTAL CABLE LENGTH-Feeder(216F)	-
TOTAL CABLE LENGTH-Subfeeder(72F)	1,563m
TOTAL CABLE LENGTH-Subfeeder(24F)	627m
TOTAL CABLE LENGTH-ODN(24F)	5,599m
TOTAL SPAN	176
SINGLE NAP	44
DOUBLE NAP	-
TOTAL NUMBER OF ACTIVE NAP	44
FUTURE NAPS	-
LCP (1:4)	15
LCP (1:8)	-
TOTAL NUMBER OF LCP	15
TOTAL NUMBER OF EMPTY NAPS	-
1ST LCP TO OLT CABLE LENGTH	7,356m
DISTANCE OF FARTHEST NAP TO OLT	9,817m
EXTENDED MESSENGER LENGTH	-
CREATED LINES	352
LOTS WITH HOUSES	758
LOTS WITH ABANDONED HOUSES	-
VACANT LOTS	91
TOTAL NUMBER OF LOTS	849
WORKING LINES	-
PROPOSED 72F CLOSURE	1
NEW POLE (25FT) MECHANICAL	30
0.6X0.6X0.6 CONCRETE ENCASEMENT	20
PROPOSED DOWN SIDE GUY	10

POI Information

Homing Exchange	-----
Feeder Cable ID / Feeder Control Number	-----
OLT NODE NAME	-----
OLT CODE	-----
Core Assignment	-----
Distance from POI to OLT	7,314m

LINK LOSS BUDGET COMPUTATION

OLT		FEEDER		SUB-FEEDER		LCP		DISTRIBUTION		NAP
Power Level dbm	Distance km	3								
ITEM	OLT Connector	ODF Connector	ODF-Feeder Splice	Feeder Sub-Feeder Splice	Sub-Feeder Distribution Splice	Distribution LCP Splice	LCP-OLT Splice	Distribution 216F	Distribution NAP Splice	Splitter 1:8
Insertion Loss Values	0.3	0.3	0.04	0.4	0.04	0.04	0.04	0.4	0.04	10.3
Qty	9,900	1	1	5,200,000	1	2,156,000	1	1	1	1
Computed Insertion Loss	9,900	0.3	0.3	0.04	0.4	0.862	0.04	0.04	0.04	10.300
Total	9,900	0.3								
Total Insertion Loss from OLT	9,900									
Computed Power Level from OLT	9,900									

FTTH AS BUILT PLAN		COA/CONTRACT		CONTRACTOR		REGIONAL BICS / SALES(SME or HOME) TEAM		PROJECT DELIVERY TEAM					
XXXX	CONTRACT SCHEDULE:	SOW	CONTRACTED	ACTUAL	DRAWN BY:	CHECK BY:	CERTIFIED BY:	CERTIFIED BY:	APPROVED BY:	REVIEWED BY:	ENDORSED BY:	ACKNOWLEDGED BY:	SHEET
WBS #:	ORIGINAL SCHED:	LCP	15	15	DESIGNER NAME	REGIONAL DESIGN MANAGER NAME	SALES		DEPARTMENT TEAM		APPROVED BY:		1/28
XXXXXX	ACTUAL SCHED:	FUTURE LCP	0	0			CERTIFIED BY:		CERTIFIED BY:		PROJECT ENGINEER NAME		
	START:	FUTURE NAP	0	0							TEAM LEADER NAME		
	COMPLETION:	NEW GROUNDING SYSTEM	30	30							DANGCON HEAD NAME		
	ACCEPTANCE DATE:	DNV FOC SPAN	146	141									DATE:
	EIM-HEAD NAME	SF FOC SPAN	41	37			TELECOM ENGINEER NAME		CLUSTER HEAD NAME		VSMSA COORDINATOR NAME		

AS BUILT Plan of SAMPLE BARANGAY (2/28)

Pole #	Reason for Proposed Pole	Latitude	Longitude
1	LONG SPAN	-	-
2	LONG SPAN	-	-
3	REQUIRED TO ATTACH LOOP	-	-
4	LONG SPAN	-	-
5	TRAVERSE	-	-
6	NO ELECTRIC POLE	-	-
7	LONG SPAN	-	-
8	LONG SPAN	-	-
9	NO ELECTRIC POLE	-	-
10	NO ELECTRIC POLE	-	-
11	NO ELECTRIC POLE	-	-
12	TRAVERSE	-	-
13	NO ELECTRIC POLE	-	-
14	TRAVERSE	-	-
15	TRAVERSE	-	-
16	TRAVERSE	-	-
17	NO ELECTRIC POLE	-	-
18	NO ELECTRIC POLE	-	-
19	REQUIRED TO ATTACH NAP	-	-
20	NO ELECTRIC POLE	-	-
21	NO ELECTRIC POLE	-	-
22	REQUIRED TO ATTACH NAP	-	-
23	TRAVERSE	-	-


Pole #	Reason for Proposed Pole	Latitude	Longitude
24	REQUIRED TO ATTACH NAP	-	-
25	NO ELECTRIC POLE	-	-
26	NO ELECTRIC POLE	-	-
27	REQUIRED TO ATTACH NAP	-	-
28	NO ELECTRIC POLE	-	-
29	NO ELECTRIC POLE	-	-
30	REQUIRED TO ATTACH NAP	-	-

-Poles conditionally AFI'd
-Subject for validation of need by Build PM on site

-Poles conditionally AFI'd
-Subject for validation of need by Build PM on site


FTTH AS BUILT PLAN		COA/CONTRACT		CONTRACTOR		REGIONAL BICS / SALES(SME or HOME) TEAM			PROJECT DELIVERY TEAM													
XXXX		CONTRACT SCHEDULE:		SOW		DRAWN BY:		CHECK BY:		CERTIFIED BY:		CERTIFIED BY:		APPROVED BY:		REVIEWED BY:		ENDORSED BY:		ACKNOWLEDGED BY:		SHEET
WBS #: XXXXXX		ORIGINAL SCHED: START: COMPLETION: ACTUAL SCHED: START: COMPLETION: ACCEPTANCE DATE:		LCP NAP FUTURE LCP FUTURE NAP NEW GROUNDING SYSTEM DOWN FOC SPAN SF FOC SPAN		DESIGNER NAME		REGIONAL DESIGN MANAGER NAME		SALES		DEPARTMENT TEAM		APPROVED BY:		PROJECT ENGINEER NAME		TEAM LEADER NAME		DMSGM HEAD NAME		2/ 28
EIM-HEAD NAME										TELECOM ENGINEER NAME		CLUSTER HEAD NAME		VSMSMS COORDINATOR NAME								DATE:

Vicinity Map of SAMPLE BARANGAY (3/28)

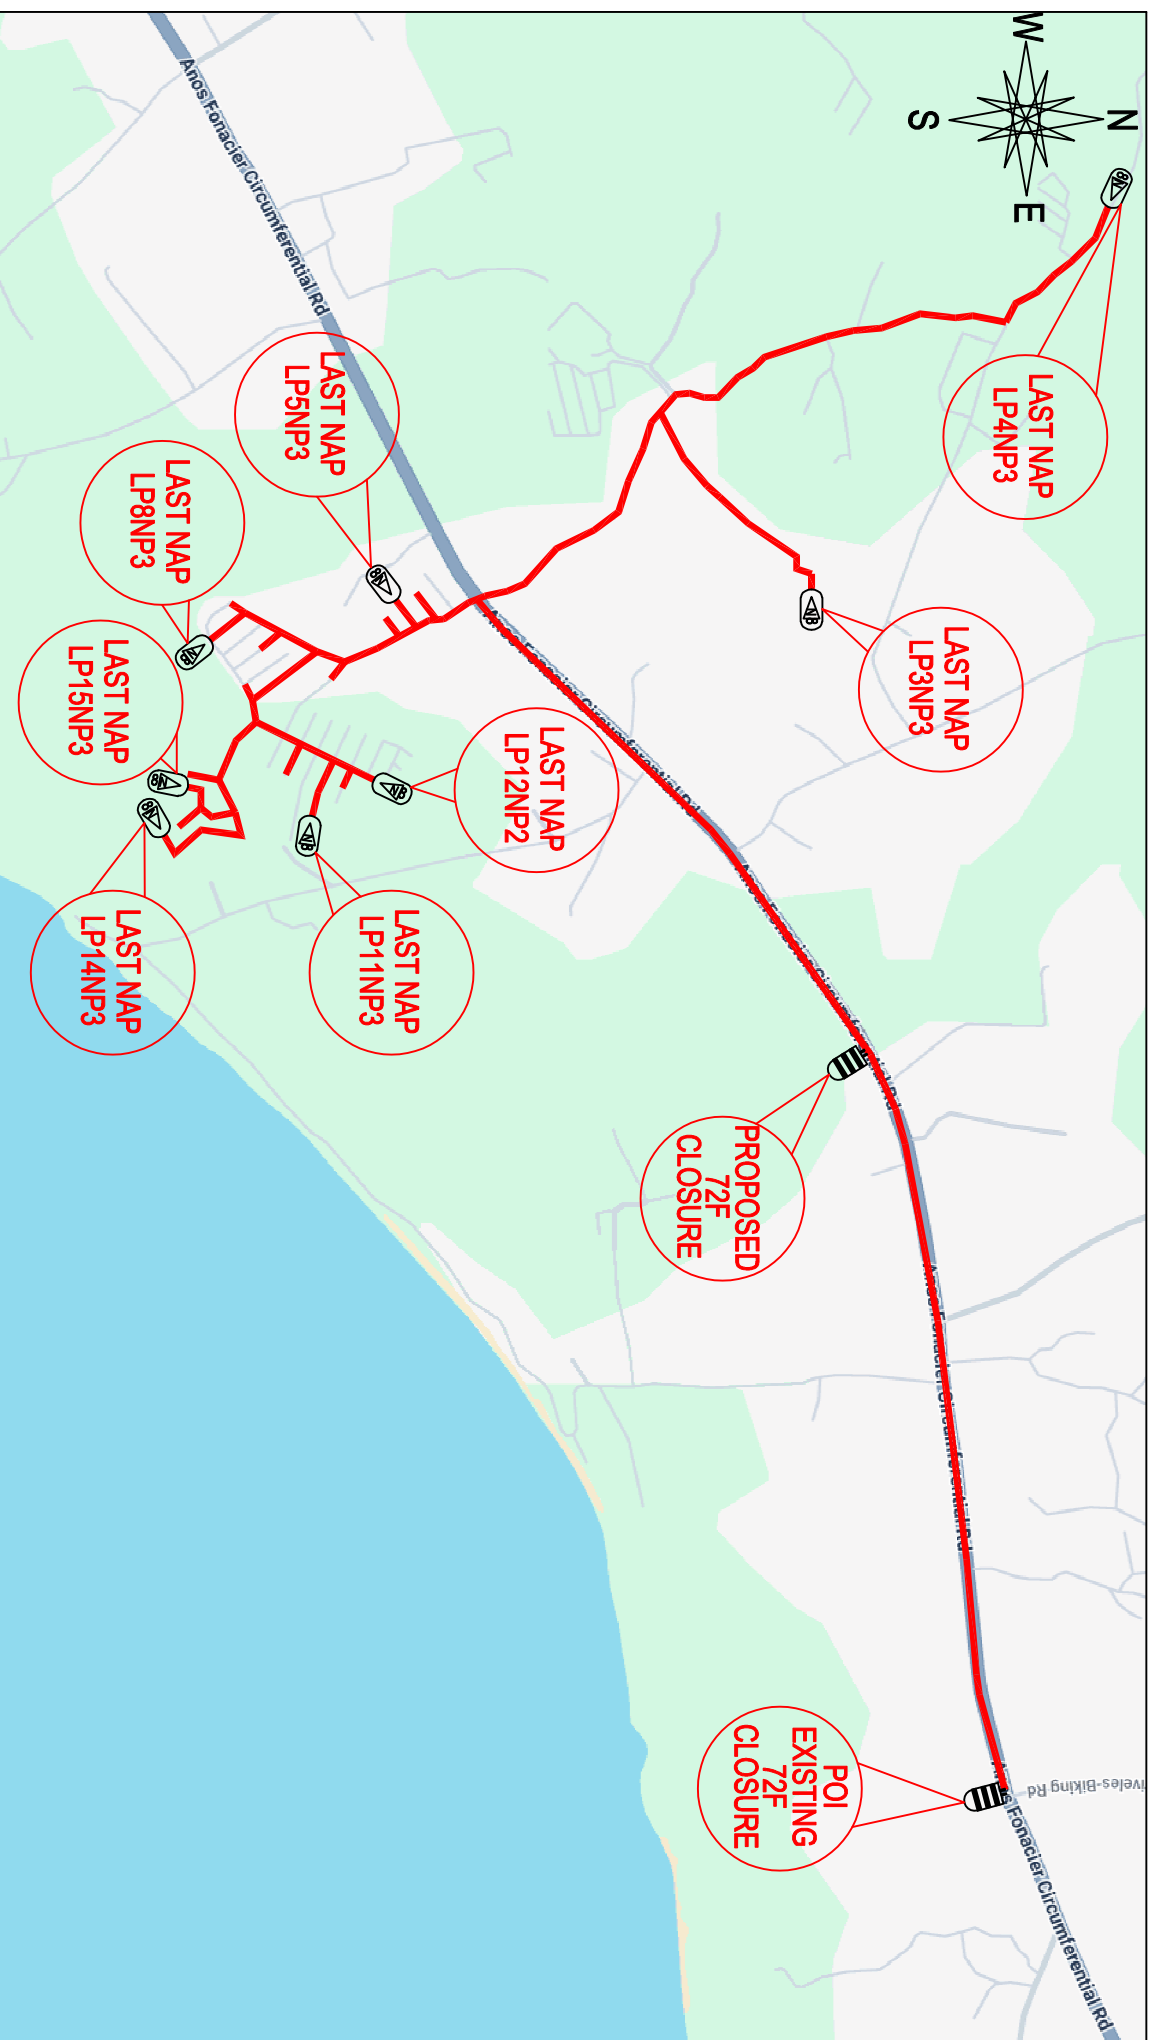


FTTH AS BUILT PLAN				COA/CONTRACT				CONTRACTOR				REGIONAL BGS / SALES(SME or HOME) TEAM				PROJECT DELIVERY TEAM																	
XXXX				CONTRACT SCHEDULE:				DRAWN BY:		CHECK BY:		CERTIFIED BY:		CERTIFIED BY:		APPROVED BY:		REVIEWED BY:		ENDORSED BY:		ACKNOWLEDGED BY:		SHEET									
WBS #:				ORIGINAL SCHED:				SOW		CONTRACTED		ACTUAL		DESIGNER NAME		REGIONAL DESIGN ENGINEER NAME		SALES		DEPARTMENT TEAM		APPROVED BY:		PROJECT ENGINEER NAME		TEAM LEADER NAME		DIVISION HEAD NAME		DATE:			
XXXXXX				START:				TOP		15		15																				44	
				ACTUAL SCHED:				FUTURE LOP		0		0																					
				START:				FUTURE MAP		0		0																					
				COMPLETION:				NEW GROUNDING SYSTEM		146		141																					
				ACCEPTANCE DATE:				CON FCC SPAN		41		37																					
EIM-HEAD NAME				SF FCC SPAN				41		37																							

Keymap of SAMPLE BARANGAY (4/28)

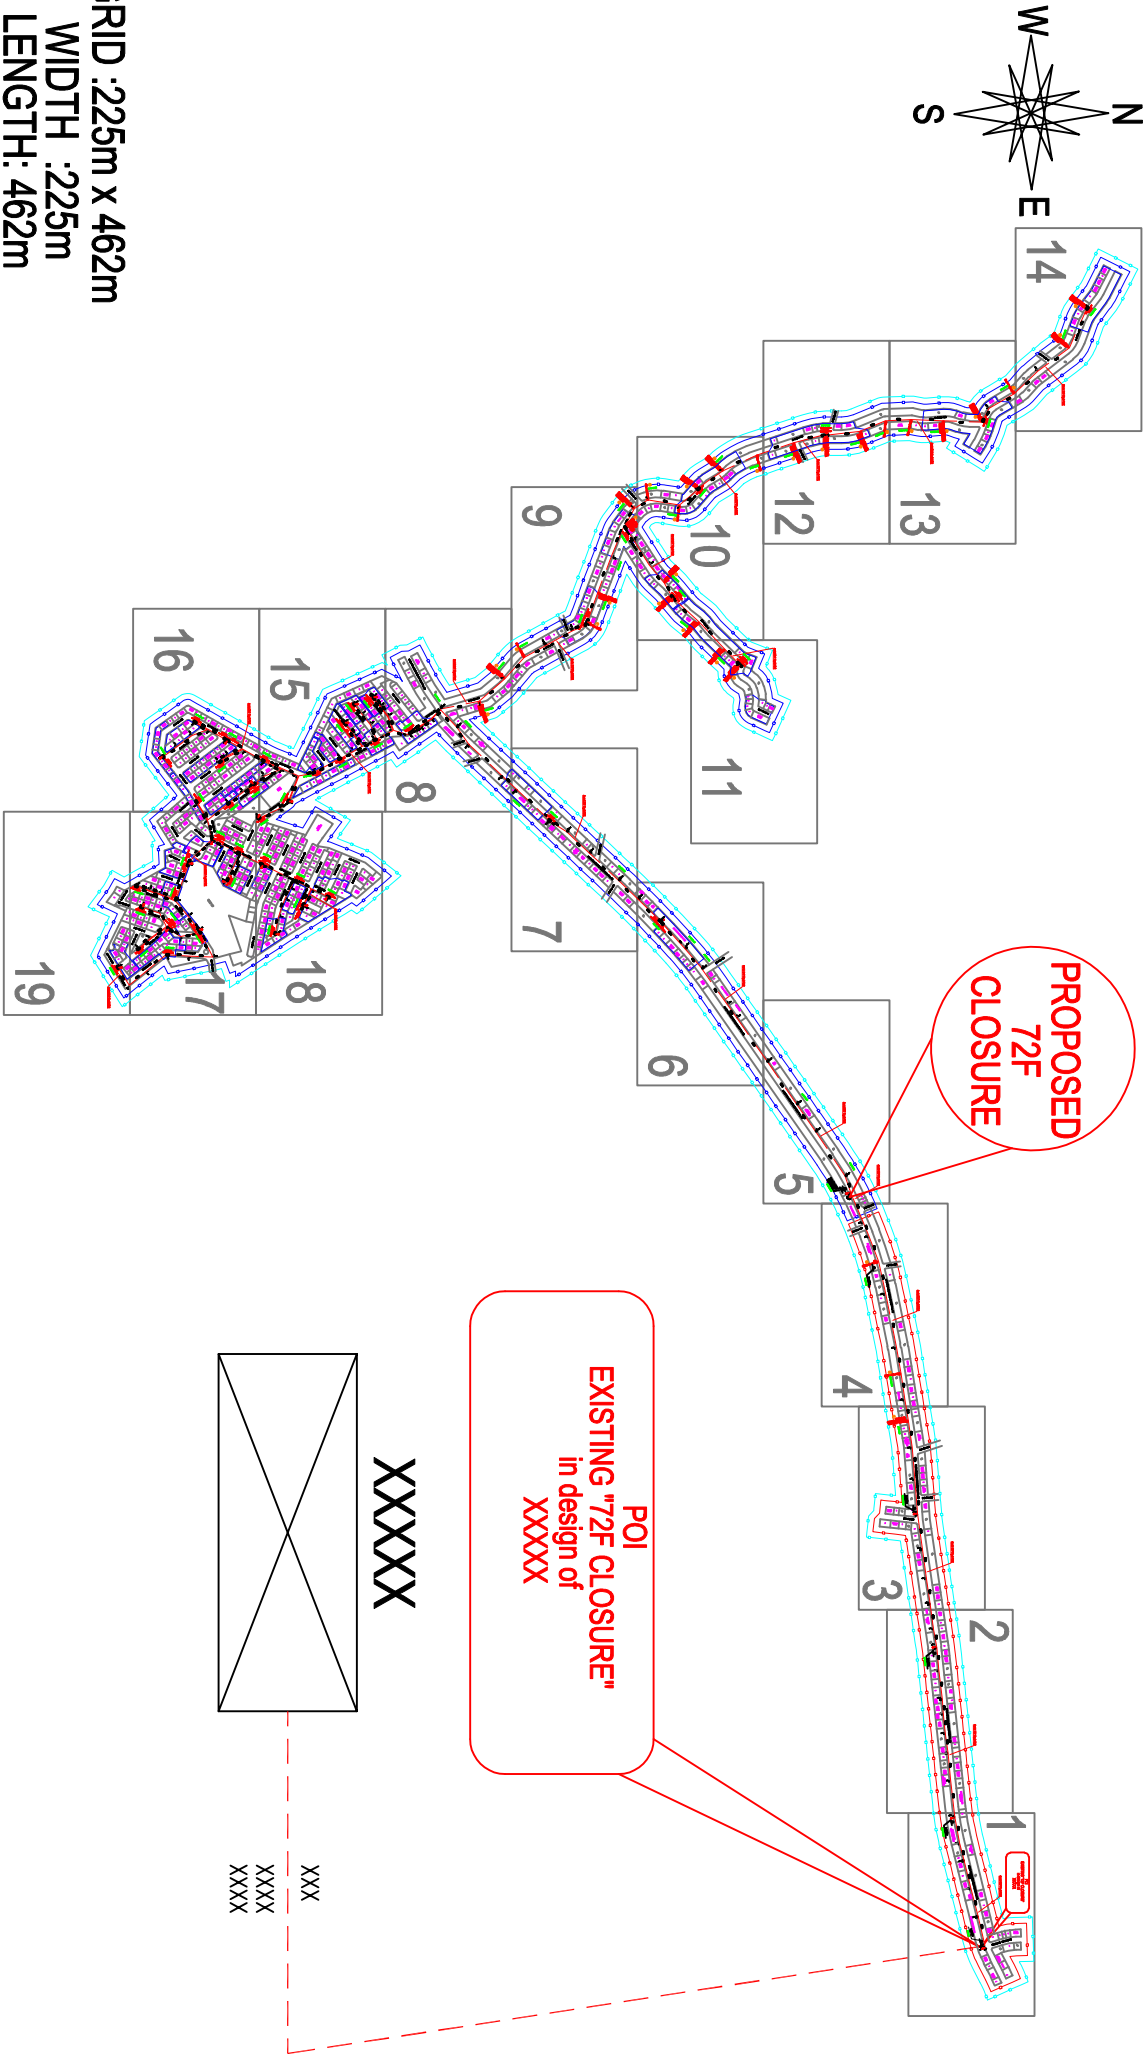


FTTH AS BUILT PLAN		COA/CONTRACT		CONTRACTOR		REGIONAL BICS / SALES(SME or HOME) TEAM		PROJECT DELIVERY TEAM		SHEET			
XXXX WBS #: XXXXXX	CONTRACT SCHEDULE:	SOW	CONTRACTED	ACTUAL	DRAWN BY:	CHECK BY:	CERTIFIED BY:	CERTIFIED BY:	APPROVED BY:	REVIEWED BY:	ENDORSED BY:	ACKNOWLEDGED BY:	DATE
	ORIGINAL SCHED:	 LCP	15	15	DESIGNER NAME	REGIONAL DESIGN MANAGER NAME	SALES	DEPARTMENT TEAM	APPROVED BY:	PROJECT ENGINEER NAME	TEAM LEADER NAME	DIVISION HEAD NAME	4/28
	START:	 MAP	44	44									
	COMPLETION:	 FUTURE LCP	0	0	CERTIFIED BY:	CERTIFIED BY:							
ACTUAL SCHED:	 MAP	0	0	APPROVED BY:									
	START:	NEW GROUNDING SYSTEM	30	30									
	COMPLETION:	ODN FOC SPAN	146	141									
	ACCEPTANCE DATE:	SF FOC SPAN	41	37									
EIM-HEAD NAME													

Keymap of SAMPLE BARANGAY (5/28)

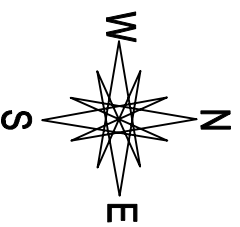

- # Existing DP's
- # Existing NAP
- P Proposed Pole



 Cabinet

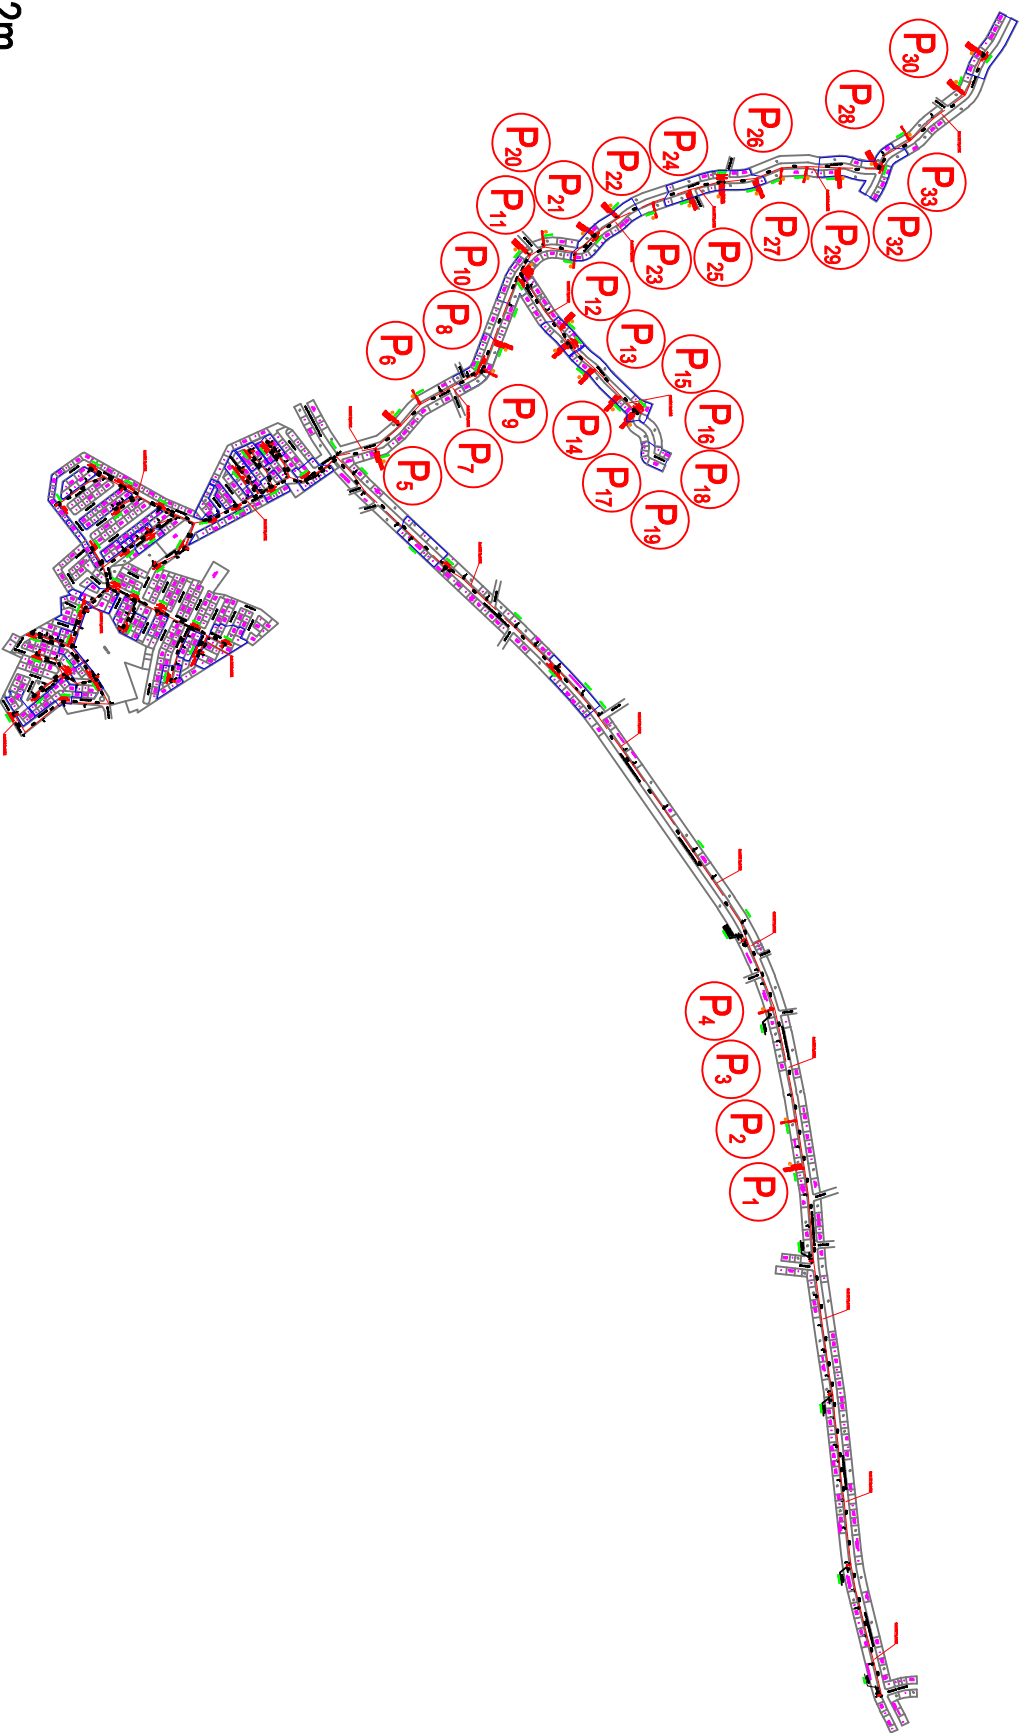

GRID :225m x 462m
WIDTH :225m
LENGTH: 462m



[illegible]

AS BUILT Plan of SAMPLE BARANGAY (6/28)

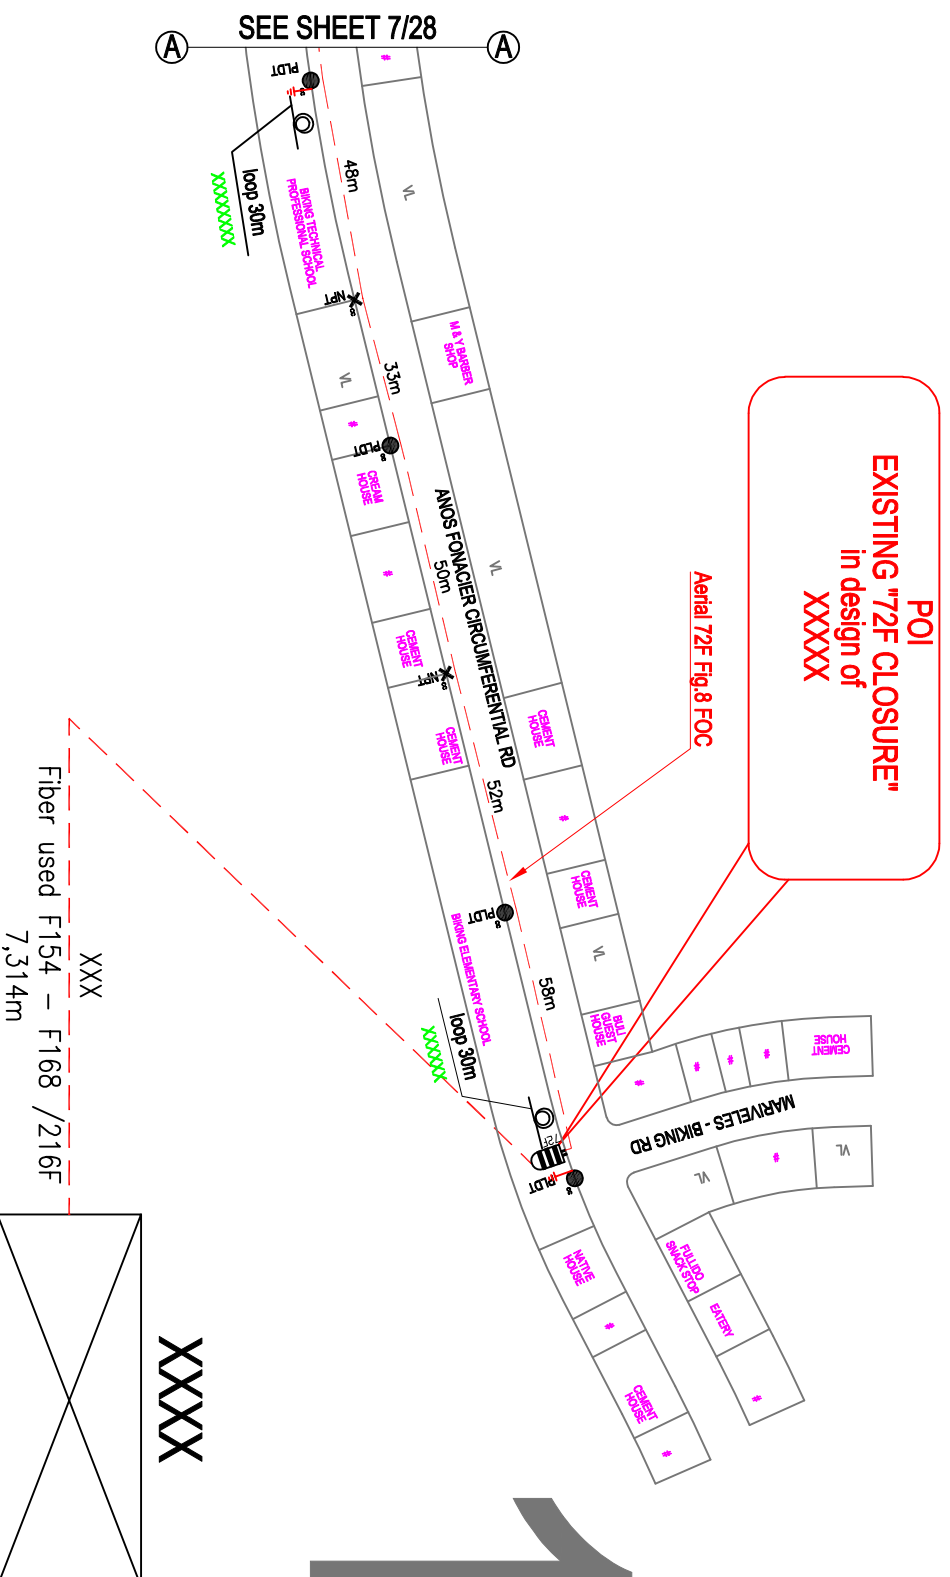
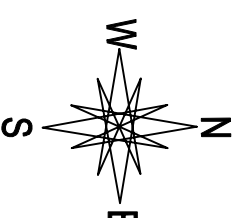


FTTH AS BUILT PLAN		COA/CONTRACT		CONTRACTOR		REGIONAL BICS / SALES(SME or HOME) TEAM		PROJECT DELIVERY TEAM		SHEET			
XXXX	CONTRACT SCHEDULE:	SOW		CONTRACTED	ACTUAL	DRAWN BY:	CHECK BY:	CERTIFIED BY:	CERTIFIED BY:	APPROVED BY:	REVIEWED BY:	ENDORSED BY:	ACKNOWLEDGED BY:
	ORIGINAL SCHED:		LCP	0	0	DESIGNER NAME	REGIONAL DESIGN MANAGER NAME	SALES	DEPARTMENT TEAM	APPROVED BY:	PROJECT ENGINEER NAME	TEAM LEADER NAME	DIVISION HEAD NAME
	START COMPLETION:		MAP	0	0								
	FUTURE LCP START:		FUTURE LCP	0	0								
XXXXXX	ACTUAL SCHED:		FUTURE MAP	0	0	CERTIFIED BY:	CERTIFIED BY:	CERTIFIED BY:	CERTIFIED BY:	APPROVED BY:	PROJECT ENGINEER NAME	TEAM LEADER NAME	DIVISION HEAD NAME
	COMPLETION:		NEW GROUNDING SYSTEM	2	2								
	ACCEPTANCE DATE:		CON FOC SPAN	0	0	TELECOM ENGINEER NAME	CLUSTER HEAD NAME	WISCONSIN COORDINATOR NAME	PROJECT ENGINEER NAME	TEAM LEADER NAME	DIVISION HEAD NAME		
			SF FOC SPAN	5	5								
DATE: 6/28													

AS BUILT Plan of SAMPLE BARANGAY (7/28)


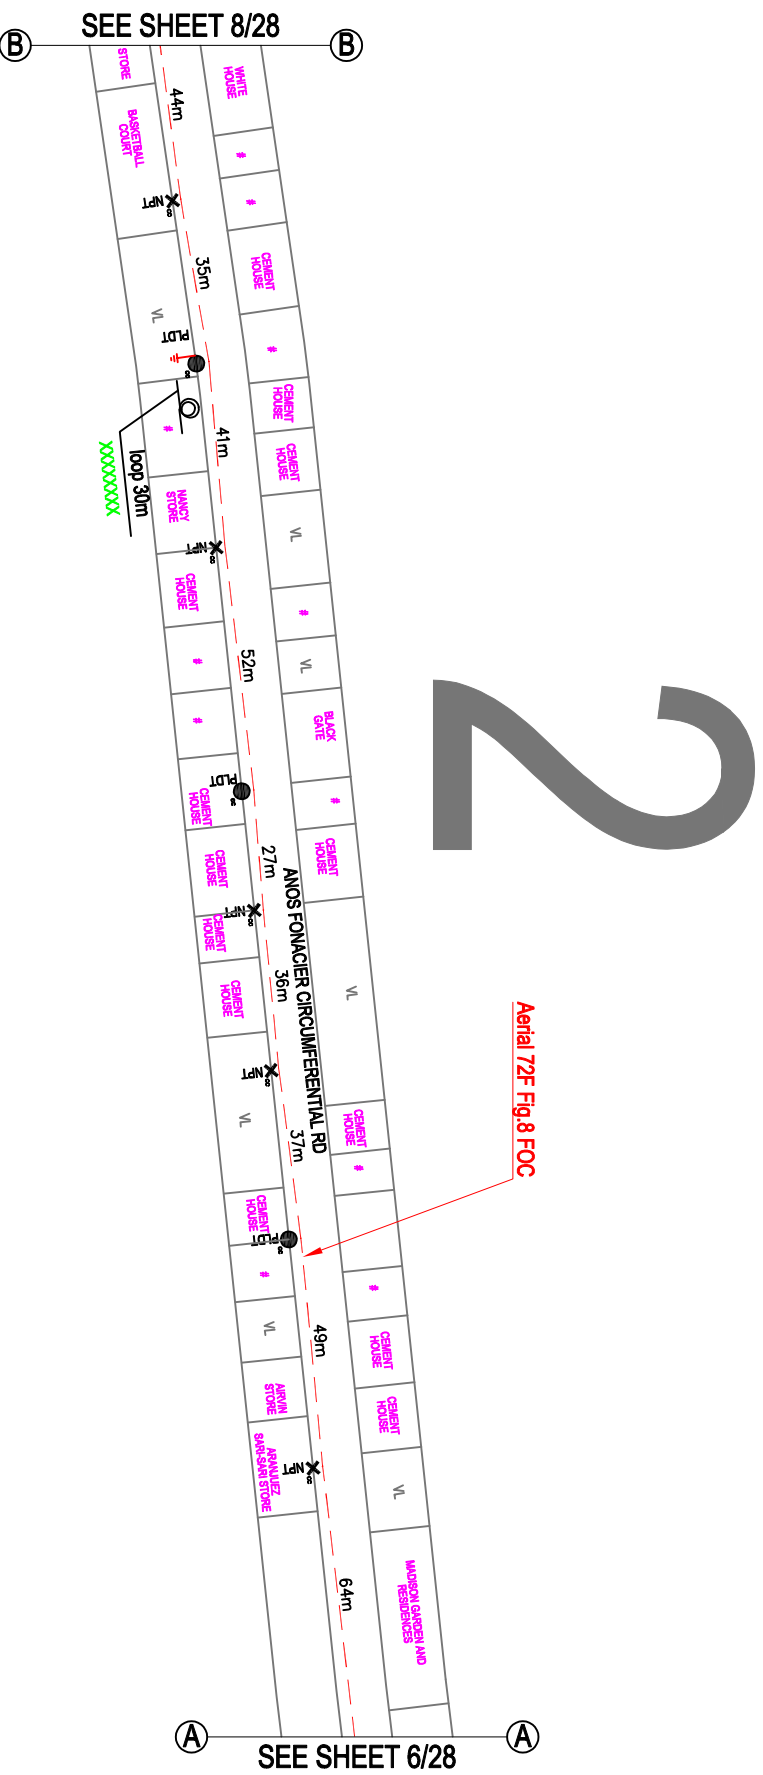
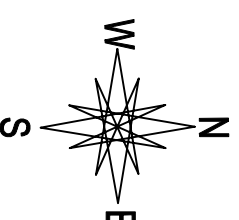
[illegible]

AS BUILT Plan of SAMPLE BARANGAY (8/28)

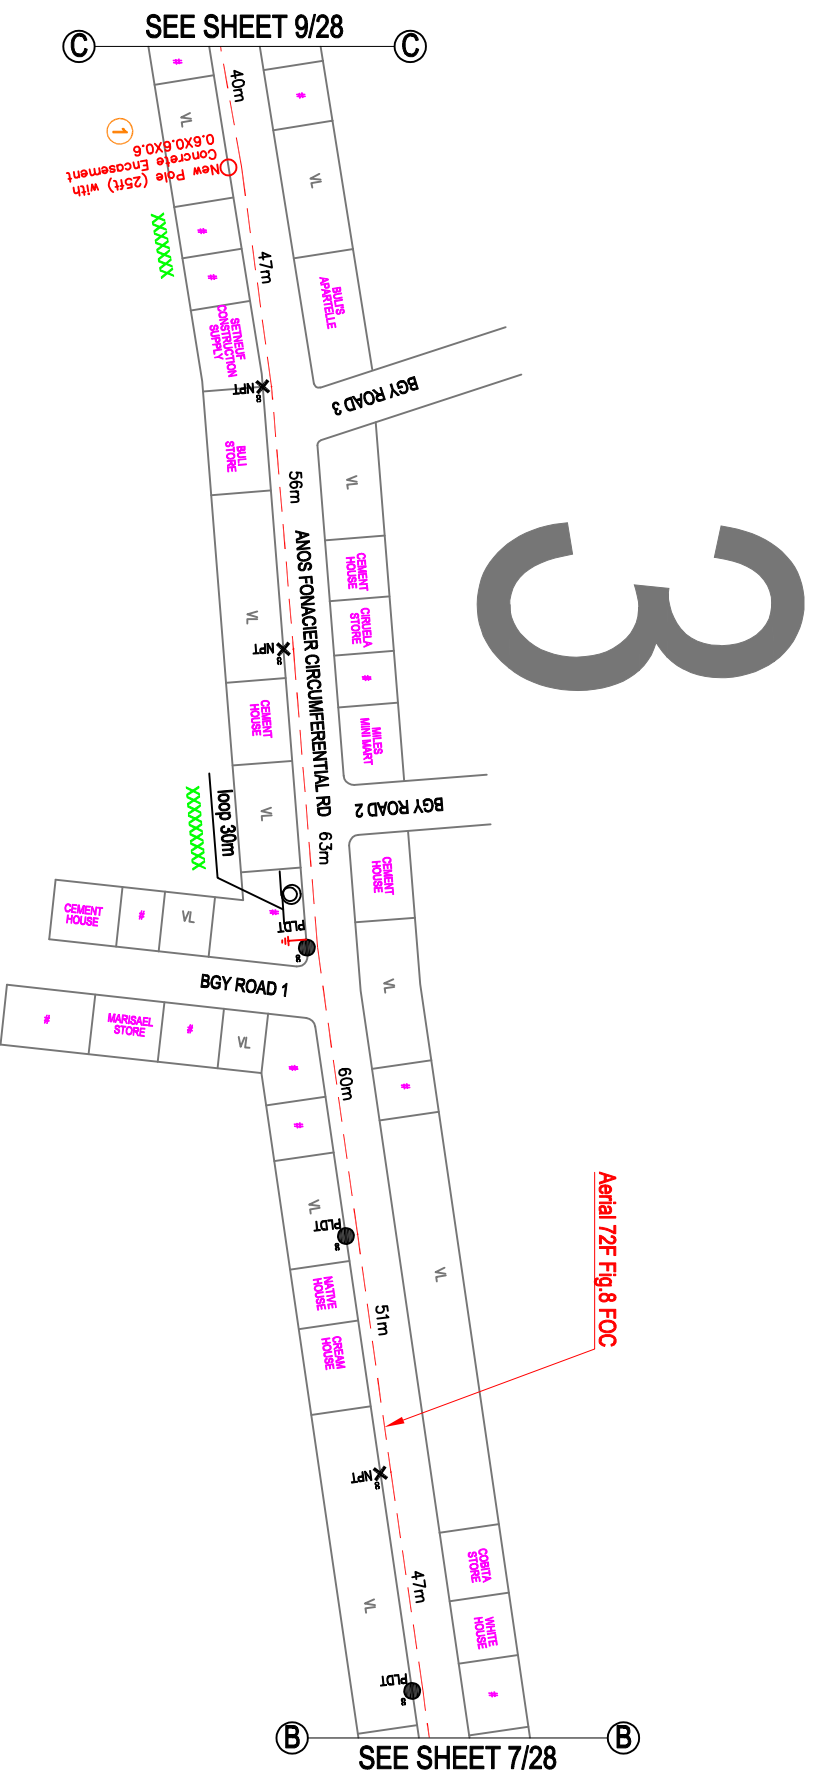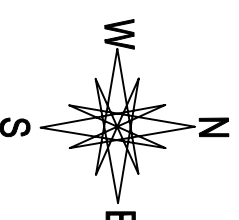



FTTH AS BUILT PLAN			COA/CONTRACT		CONTRACTOR			REGIONAL BCS / SALES(SME or HOME) TEAM			PROJECT DELIVERY TEAM			SHEET
XXXX	CONTRACT SCHEDULE:	SOW	CONTRACTED	ACTUAL	DRAWN BY:	CHECK BY:	CERTIFIED BY:	CERTIFIED BY:	APPROVED BY:	REVIEWED BY:	ENDORSED BY:	ACKNOWLEDGED BY:		
WBS #: XXXXXX	ORIGINAL SCHED: START	 LCP	0	0	DESIGNER NAME	REGIONAL DESIGN MANAGER NAME	SALES	DEPARTMENT TEAM	APPROVED BY:	PROJECT ENGINEER NAME	TEAM LEADER NAME	DIVISION HEAD NAME	DATE: 8/28	
	FUTURE LCP START	 FUTURE LCP	0	0										
	FUTURE NAP START	 FUTURE NAP	0	0										
	NEW GROUNDING SYSTEM	 NEW GROUNDING SYSTEM	1	1										
	ACCEPTANCE DATE:	 CON. FOR SPAN	0	0			TELECOM ENGINEER NAME	CLUSTER HEAD NAME	NCMS COORDINATOR NAME					
		SF FOR SPAN	7	7										
EIM-HEAD NAME														

AS BUILT Plan of SAMPLE BARANGAY (9/28)

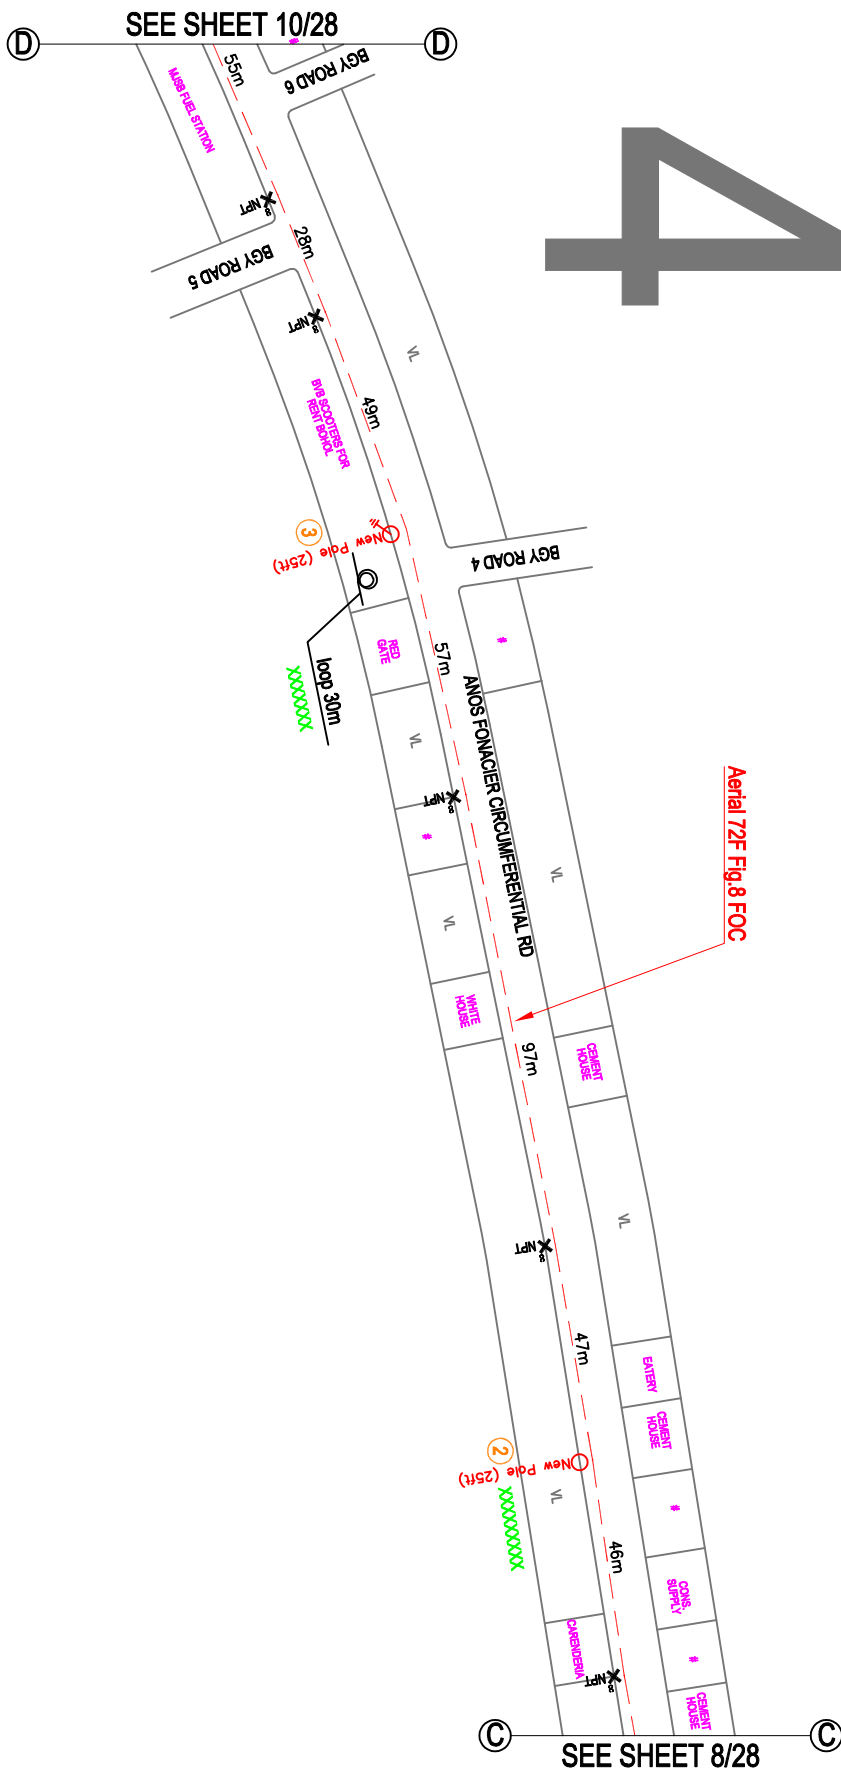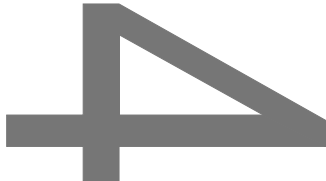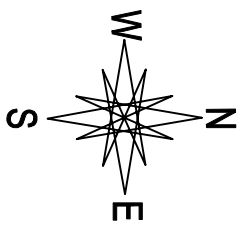

FTTH AS BUILT PLAN		COA/CONTRACT		CONTRACTOR		REGIONAL BICS / SALES(SME or HOME) TEAM		PROJECT DELIVERY TEAM		SHEET				
XXXX WBS #: XXXXXX	CONTRACT SCHEDULE:	SOW	CONTRACTED	ACTUAL	DRAWN BY:	CHECK BY:	CERTIFIED BY:	CERTIFIED BY:	APPROVED BY:	REVIEWED BY:	ENDORSED BY:	ACKNOWLEDGED BY:	9/28 DATE:	
	ORIGINAL SCHED: START:	 LCP	0	0	DESIGNER NAME	REGIONAL DESIGN MANAGER NAME	SALES	DEPARTMENT TEAM		APPROVED BY:	PROJECT ENGINEER NAME	TEAM LEADER NAME		DIVISION HEAD NAME
	COMPLETION:	 FUTURE LCP	0	0										
	ACTUAL SCHED: START:	 FUTURE LCP	0	0	CERTIFIED BY:	CERTIFIED BY:								
COMPLETION:	NEW GROUNDING SYSTEM	1	1											
ACCEPTANCE DATE:	OWN FOC SPAN	0	0											
	SF FOC SPAN	8	7											
EIM-HEAD NAME														



AS BUILT Plan of SAMPLE BARANGAY (10/28)

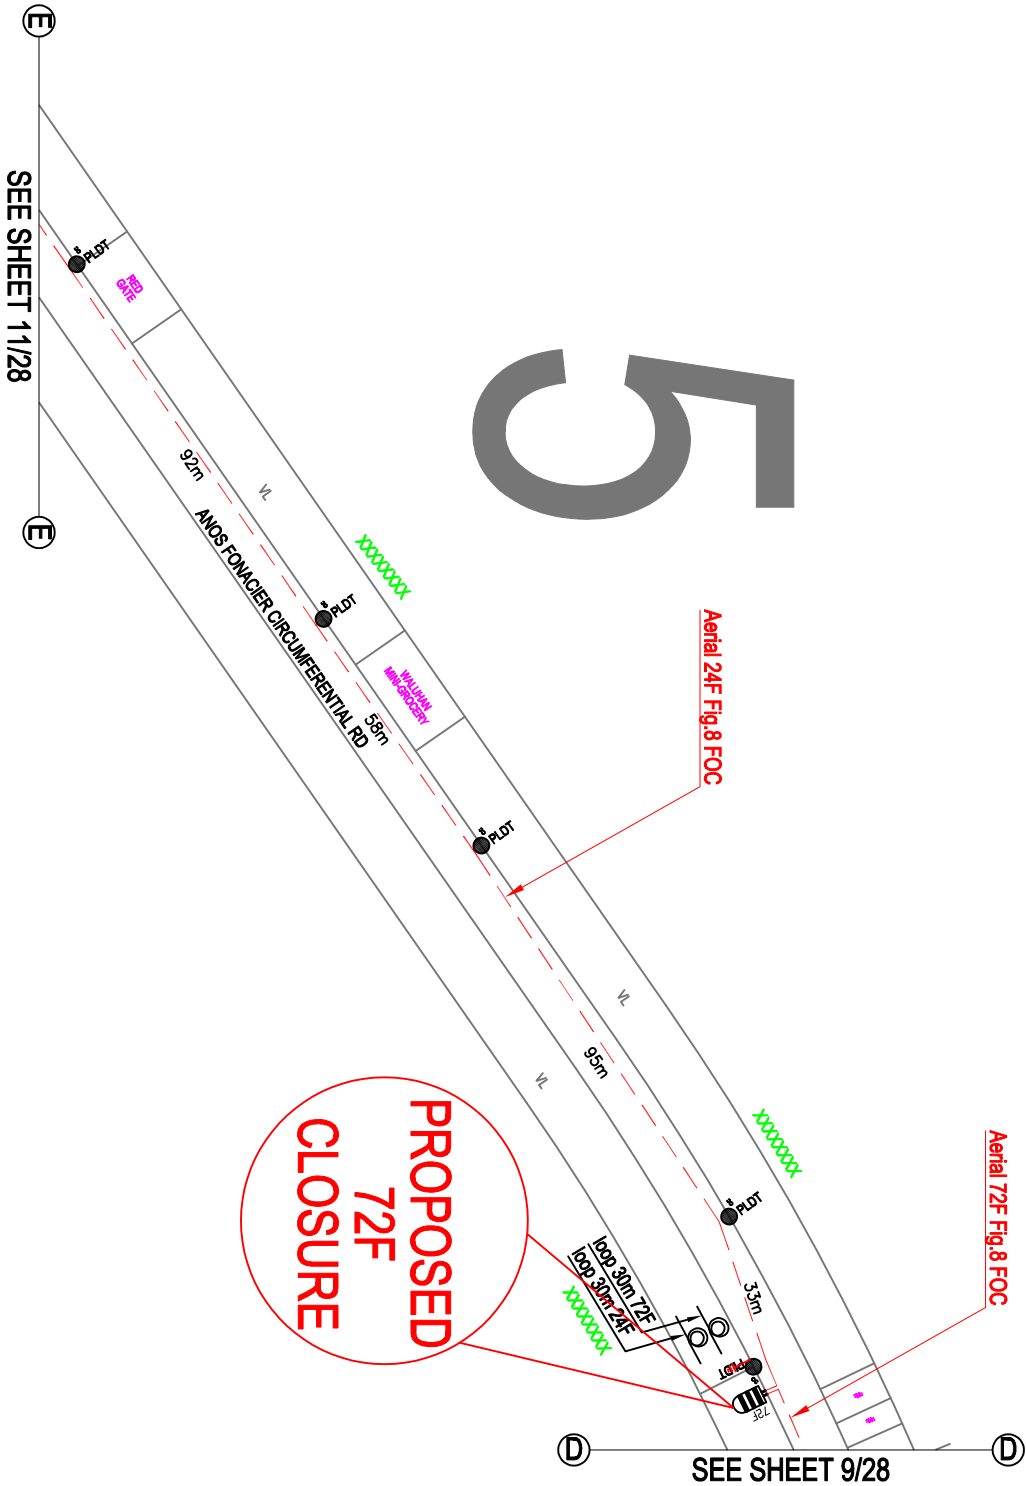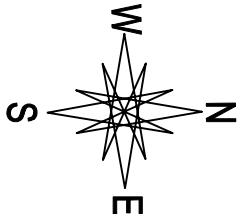



FTTH AS BUILT PLAN		COA/CONTRACT		CONTRACTOR		REGIONAL BICS / SALES(SME or HOME) TEAM		PROJECT DELIVERY TEAM		SHEET		
XXXX WBS #: XXXXXX	CONTRACT SCHEDULE:	SOW	CONTRACTED	ACTUAL	DRAWN BY:	CHECK BY:	CERTIFIED BY:	CERTIFIED BY:	REVIEWED BY:	ENDORSED BY:	ACKNOWLEDGED BY:	DATE
	ORIGINAL SCHED:	 LCP	0	0	DESIGNER NAME	REGIONAL DESIGN MANAGER NAME	SALES	DEPARTMENT TEAM	APPROVED BY:	PROJECT ENGINEER NAME	TEAM LEADER NAME	10/28
	START:	 MAP	0	0								
	COMPLETION:	 FUTURE LCP	0	0								
ACTUAL SCHED:	 FUTURE MAP	0	0									
START:	NEW GROUNDING SYSTEM	1	1									
COMPLETION:	ODN FOC SPAN	0	0									
ACCEPTANCE DATE:	SF FOC SPAN	6	4									
EIM-HEAD NAME												

AS BUILT Plan of SAMPLE BARANGAY (11/28)

SEE SHEET 10/28

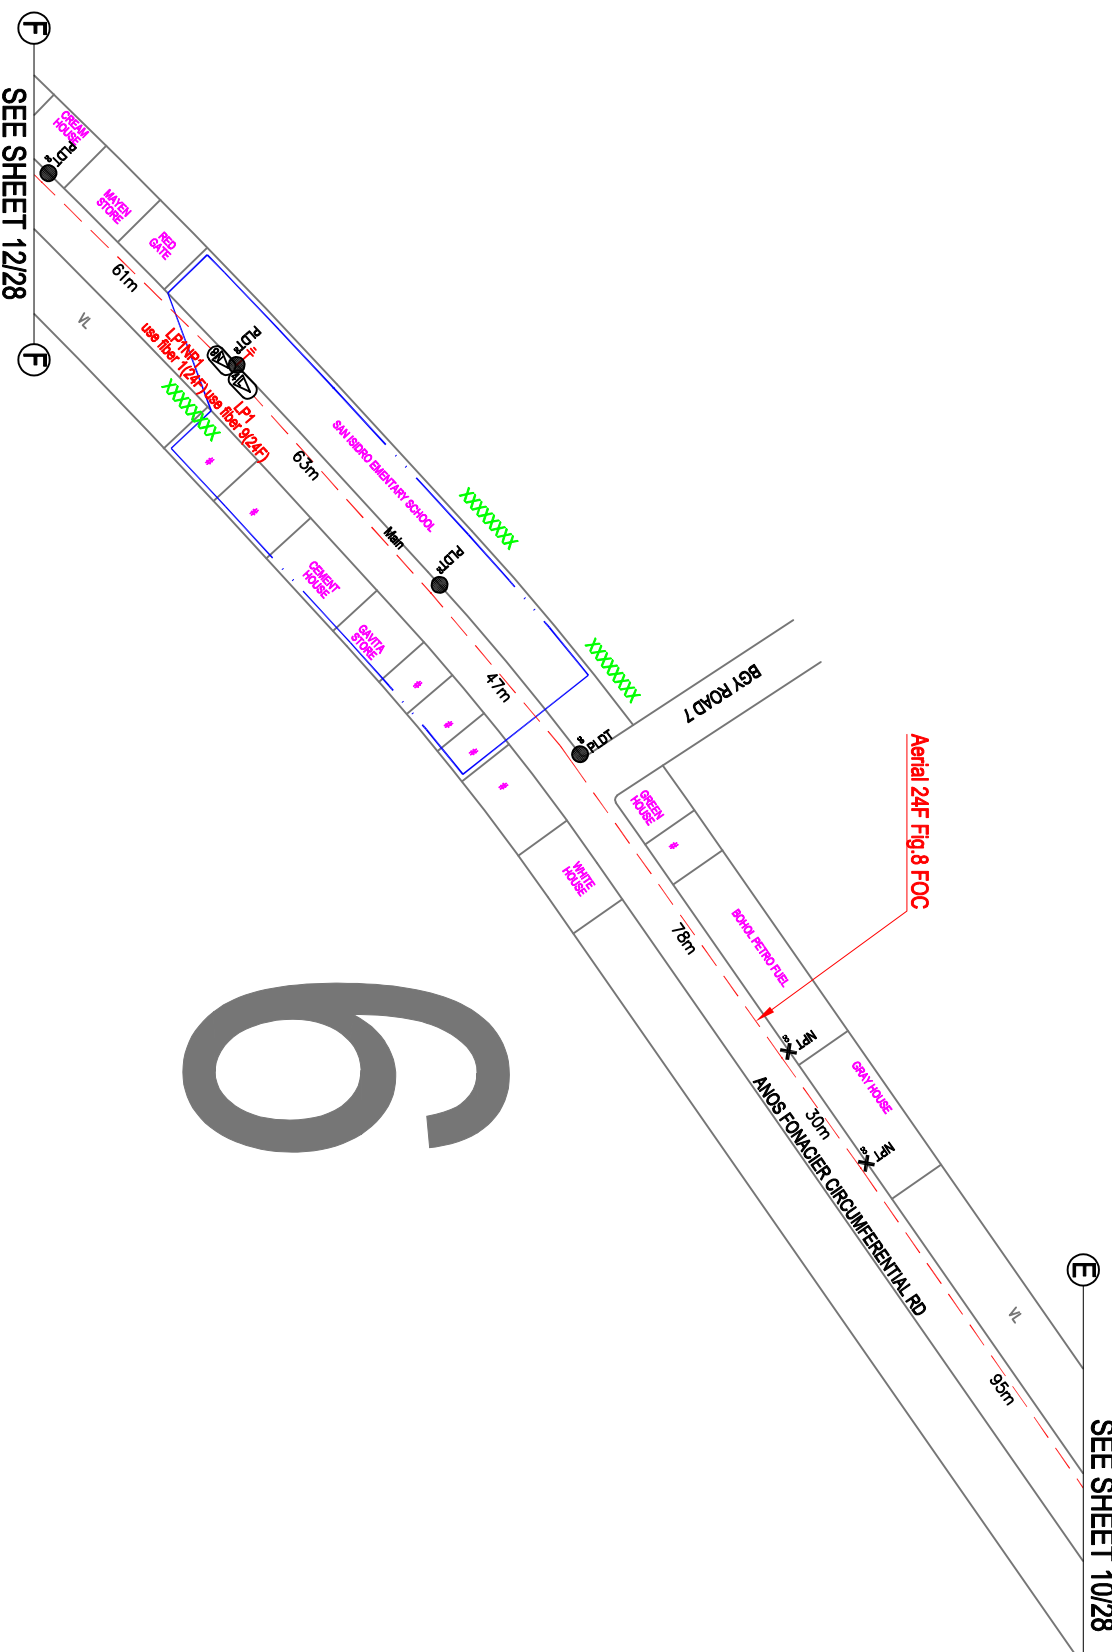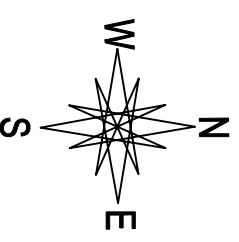
[illegible]

AS BUILT Plan of SAMPLE BARANGAY (12/28)

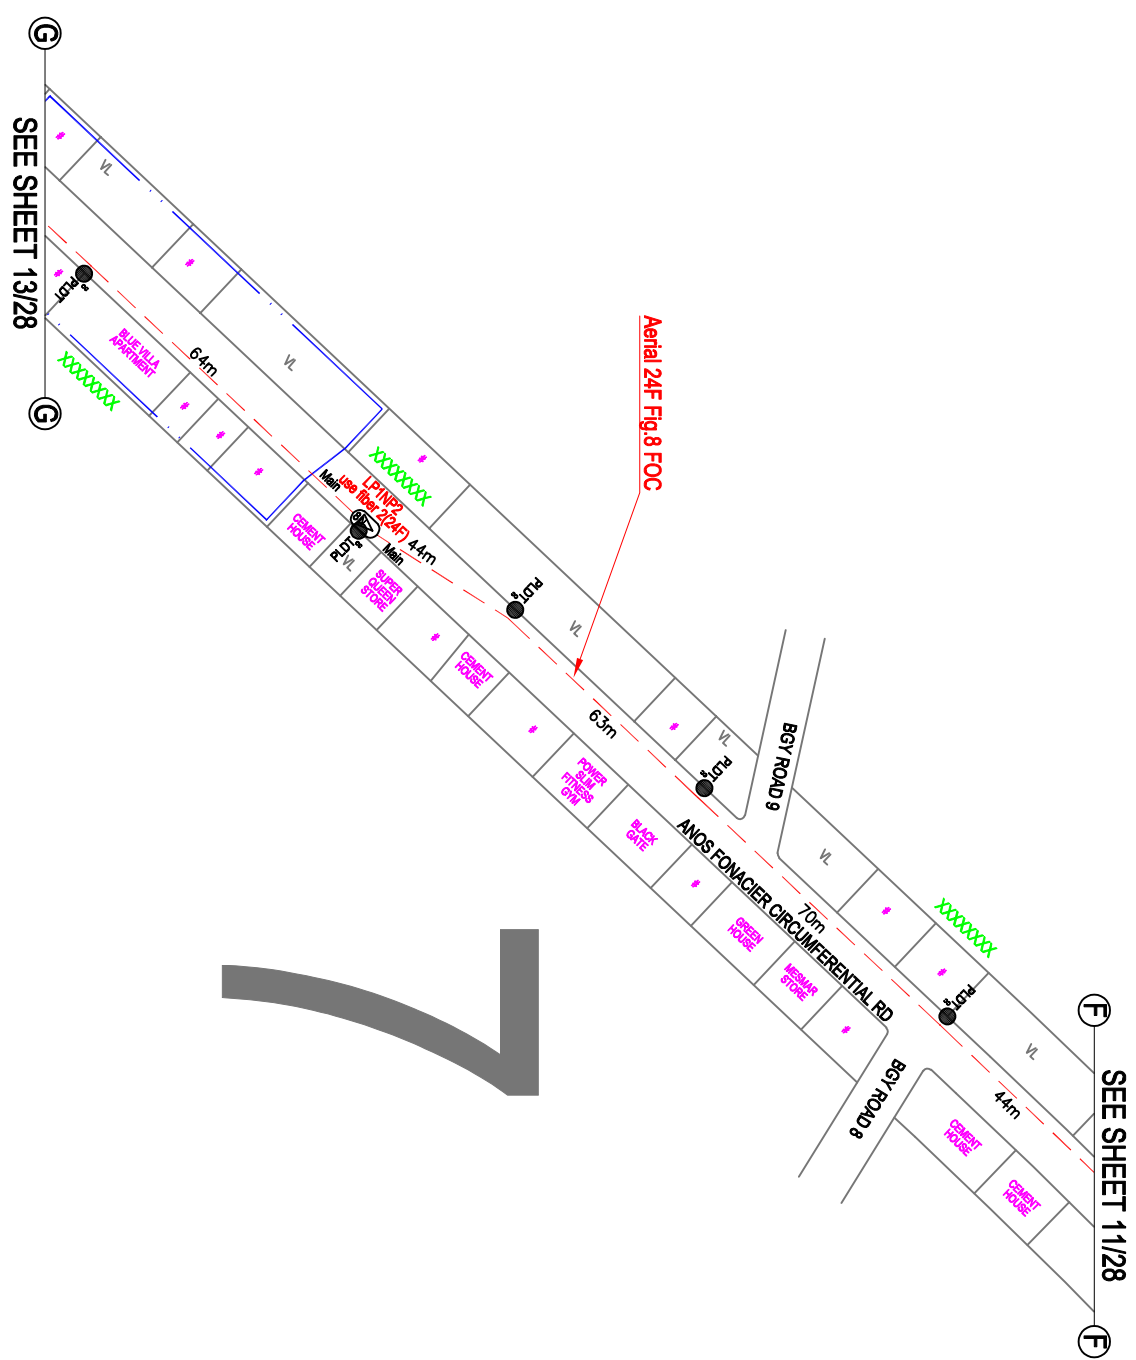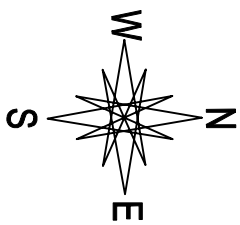


FTTH AS BUILT PLAN		COA/CONTRACT		CONTRACTOR		REGIONAL BICS / SALES(SME or HOME) TEAM		PROJECT DELIVERY TEAM		SHEET				
XXXX WBS #: XXXXXX	CONTRACT SCHEDULE:		SOW	CONTRACTED	ACTUAL	DRAWN BY:	CHECK BY:	CERTIFIED BY:	CERTIFIED BY:	APPROVED BY:	REVIEWED BY:	ENDORSED BY:	ACKNOWLEDGED BY:	12/28 DATE:
	ORIGINAL SCHED: START:		 LCP	0	0			SALES						
	COMPLETION:		 MAP	1	1			DEPARTMENT TEAM						
	ACTUAL SCHED: START:		 FUTURE LCP	0	0			CERTIFIED BY:	CERTIFIED BY:	APPROVED BY:				
	COMPLETION:		 NEW GROUNDING SYSTEM	0	0									
ACCEPTANCE DATE:		ODN FOC SPAN	0	5	0			TELECOM ENGINEER NAME	CUSTOMER HEAD NAME	WISDOMS COORDINATOR NAME	PROJECT ENGINEER NAME	TEAM LEADER NAME	DIVISION HEAD NAME	
EIM-HEAD NAME		SF FOC SPAN		0	0									

AS BUILT Plan of SAMPLE BARANGAY (13/28)

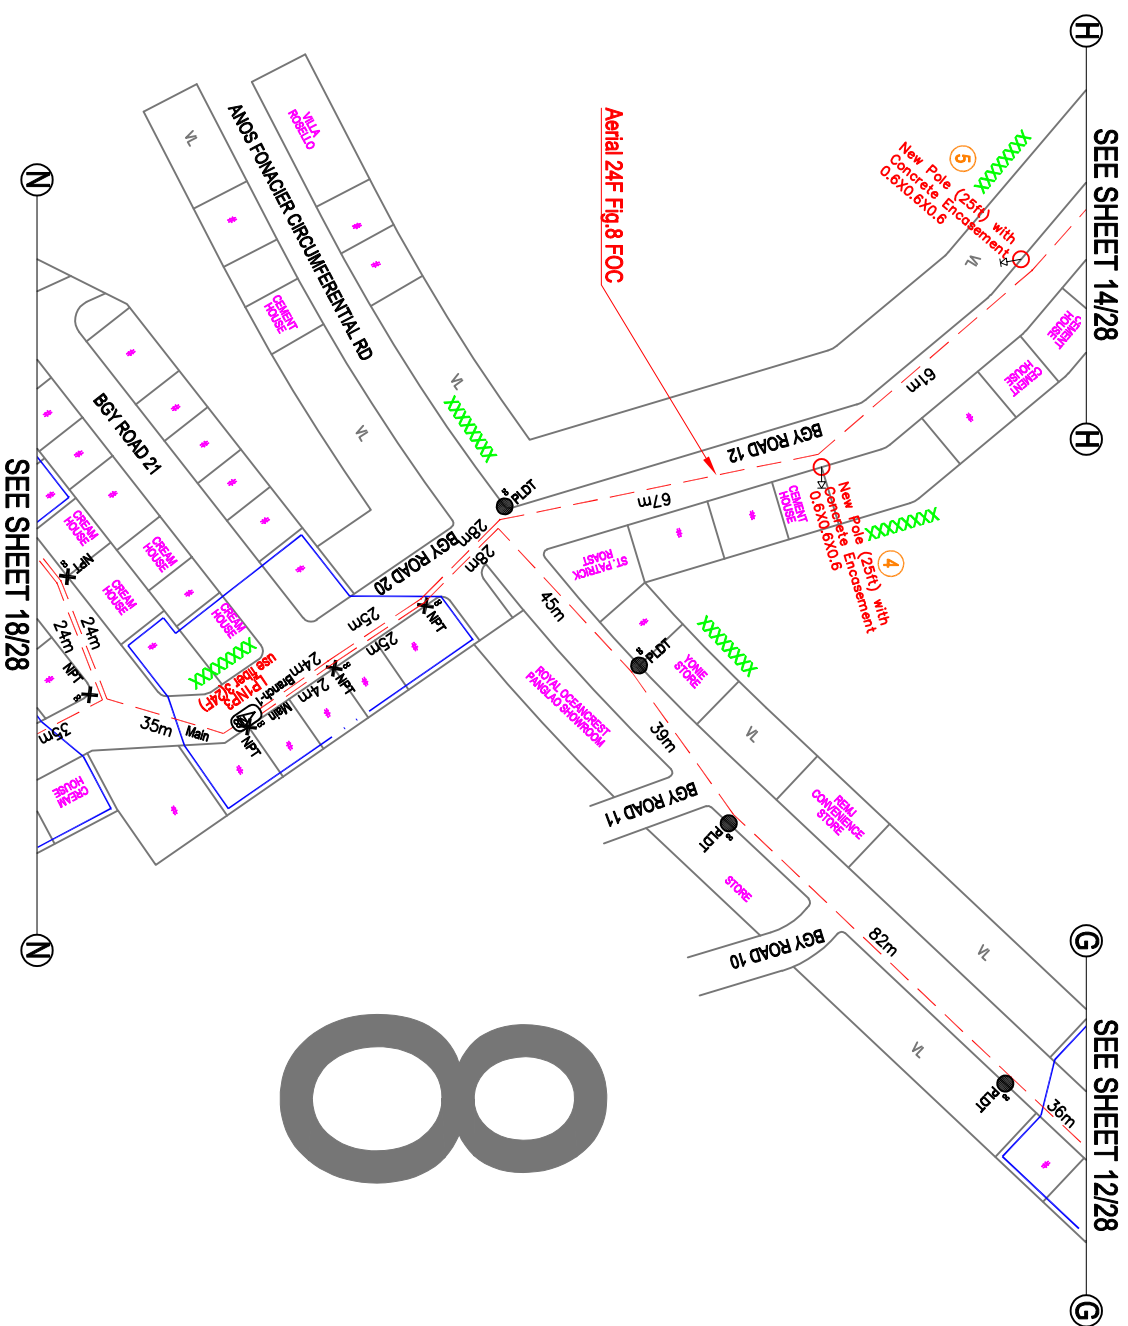



FTTH AS BUILT PLAN		COA/CONTRACT		CONTRACTOR		REGIONAL BICS / SALES(SME or HOME) TEAM		PROJECT DELIVERY TEAM		SHEET					
XXXX WBS #: XXXXXX	CONTRACT SCHEDULE:		SOW	CONTRACTED	ACTUAL	DRAWN BY:	CHECK BY:	CERTIFIED BY:	CERTIFIED BY:	APPROVED BY:	REVIEWED BY:	ENDORSED BY:	ACKNOWLEDGED BY:	13/ 28	
	ORIGINAL SCHED:		 LCP	1	0	DESIGNER NAME	REGIONAL DESIGN MANAGER NAME	SALES	DEPARTMENT TEAM		APPROVED BY:	PROJECT ENGINEER NAME	TEAM LEADER NAME		DIVISION HEAD NAME
	START:		 FUTURE LCP	1	1										
	COMPLETION:		 MAP	0	0	CERTIFIED BY:	CERTIFIED BY:	CERTIFIED BY:	CERTIFIED BY:	CERTIFIED BY:					
	ACTUAL SCHED:		 FUTURE LCP	0	0	APPROVED BY:		APPROVED BY:		APPROVED BY:					
START:		 MAP	0	0	APPROVED BY:		APPROVED BY:		APPROVED BY:		APPROVED BY:		APPROVED BY:		
COMPLETION:		NEW GROUNDING SYSTEM	1	0	APPROVED BY:		APPROVED BY:		APPROVED BY:		APPROVED BY:		APPROVED BY:		
ACCEPTANCE DATE:		ODN FOC SPAN	19	15	APPROVED BY:		APPROVED BY:		APPROVED BY:		APPROVED BY:		APPROVED BY:		
		SF FOC SPAN	0	0	APPROVED BY:		APPROVED BY:		APPROVED BY:		APPROVED BY:		APPROVED BY:		
EIM-HEAD NAME						TELECOM ENGINEER NAME		CUSTOMER HEAD NAME		MS&MS COORDINATOR NAME		DATE:			

AS BUILT Plan of SAMPLE BARANGAY (14/28)

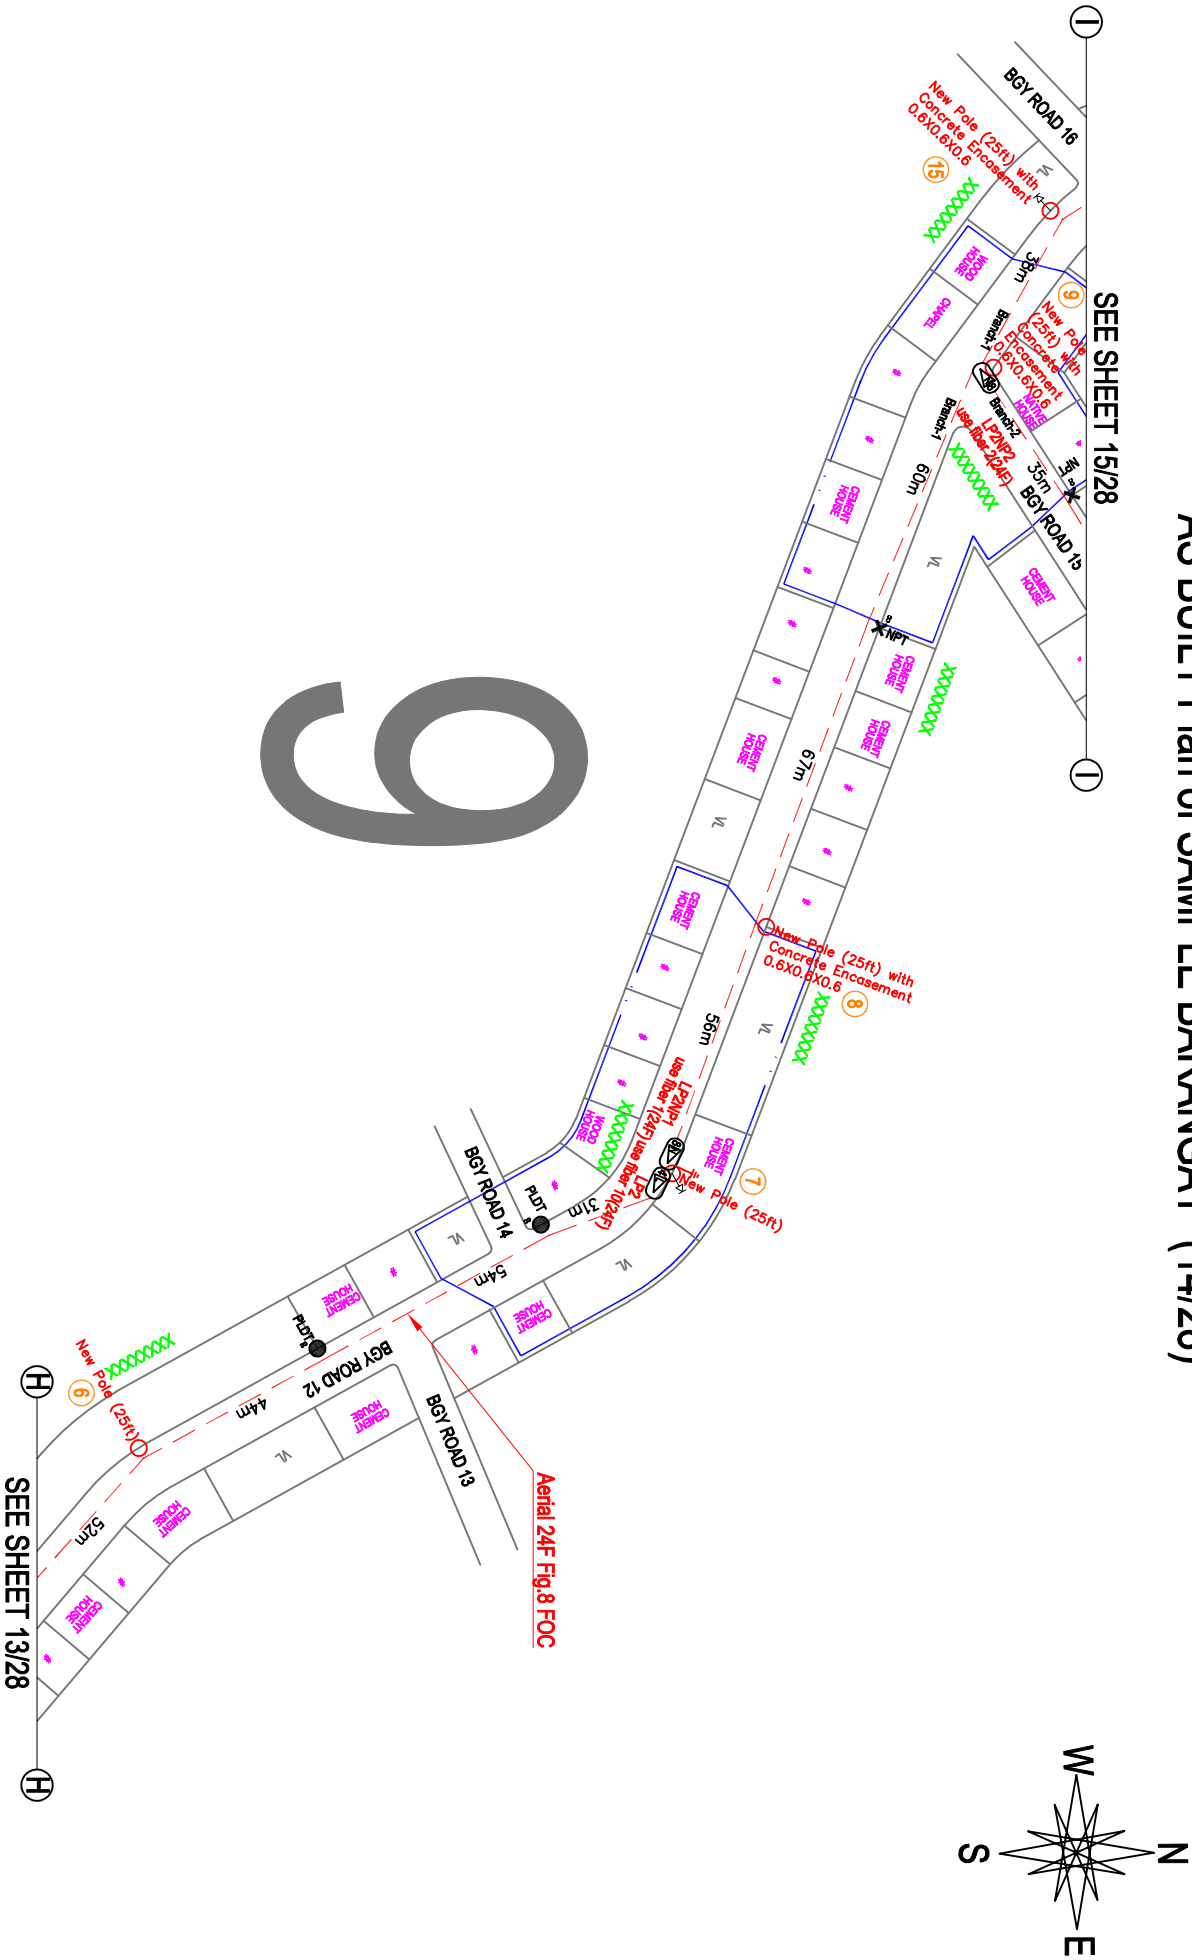

FTTH AS BUILT PLAN		COA/CONTRACT		CONTRACTOR		REGIONAL BICS / SALES(SME or HOME) TEAM		PROJECT DELIVERY TEAM		SHEET		
XXXX	CONTRACT SCHEDULE:	SOW	CONTRACTED	ACTUAL	DRAWN BY:	CHECK BY:	CERTIFIED BY:	CERTIFIED BY:	REVIEWED BY:	ENDORSED BY:	ACKNOWLEDGED BY:	
WBS #:	ORIGINAL SCHED:	 LCP	0	1	DESIGNER NAME	REGIONAL DESIGN MANAGER NAME	SALES		PROJECT ENGINEER NAME	TEAM LEADER NAME	DMSION HEAD NAME	DATE:
XXXXXX	START:	 MAP	2	2			DEPARTMENT TEAM					
	COMPLETION:	 FUTURE LCP	0	0	CERTIFIED BY:	CERTIFIED BY:	APPROVED BY:					
	ACTUAL SCHED:	 FUTURE MAP	0	0								
	START:	NEW GROUNDING SYSTEM	0	1								
	COMPLETION:	OWN FOC SPAN	9	9	TELECOM ENGINEER NAME	CLUSTER HEAD NAME	VSMS/CS COORDINATOR NAME					
	ACCEPTANCE DATE:	SF FOC SPAN	0	0								


AS BUILT Plan of SAMPLE BARANGAY (15/28)

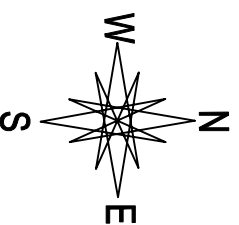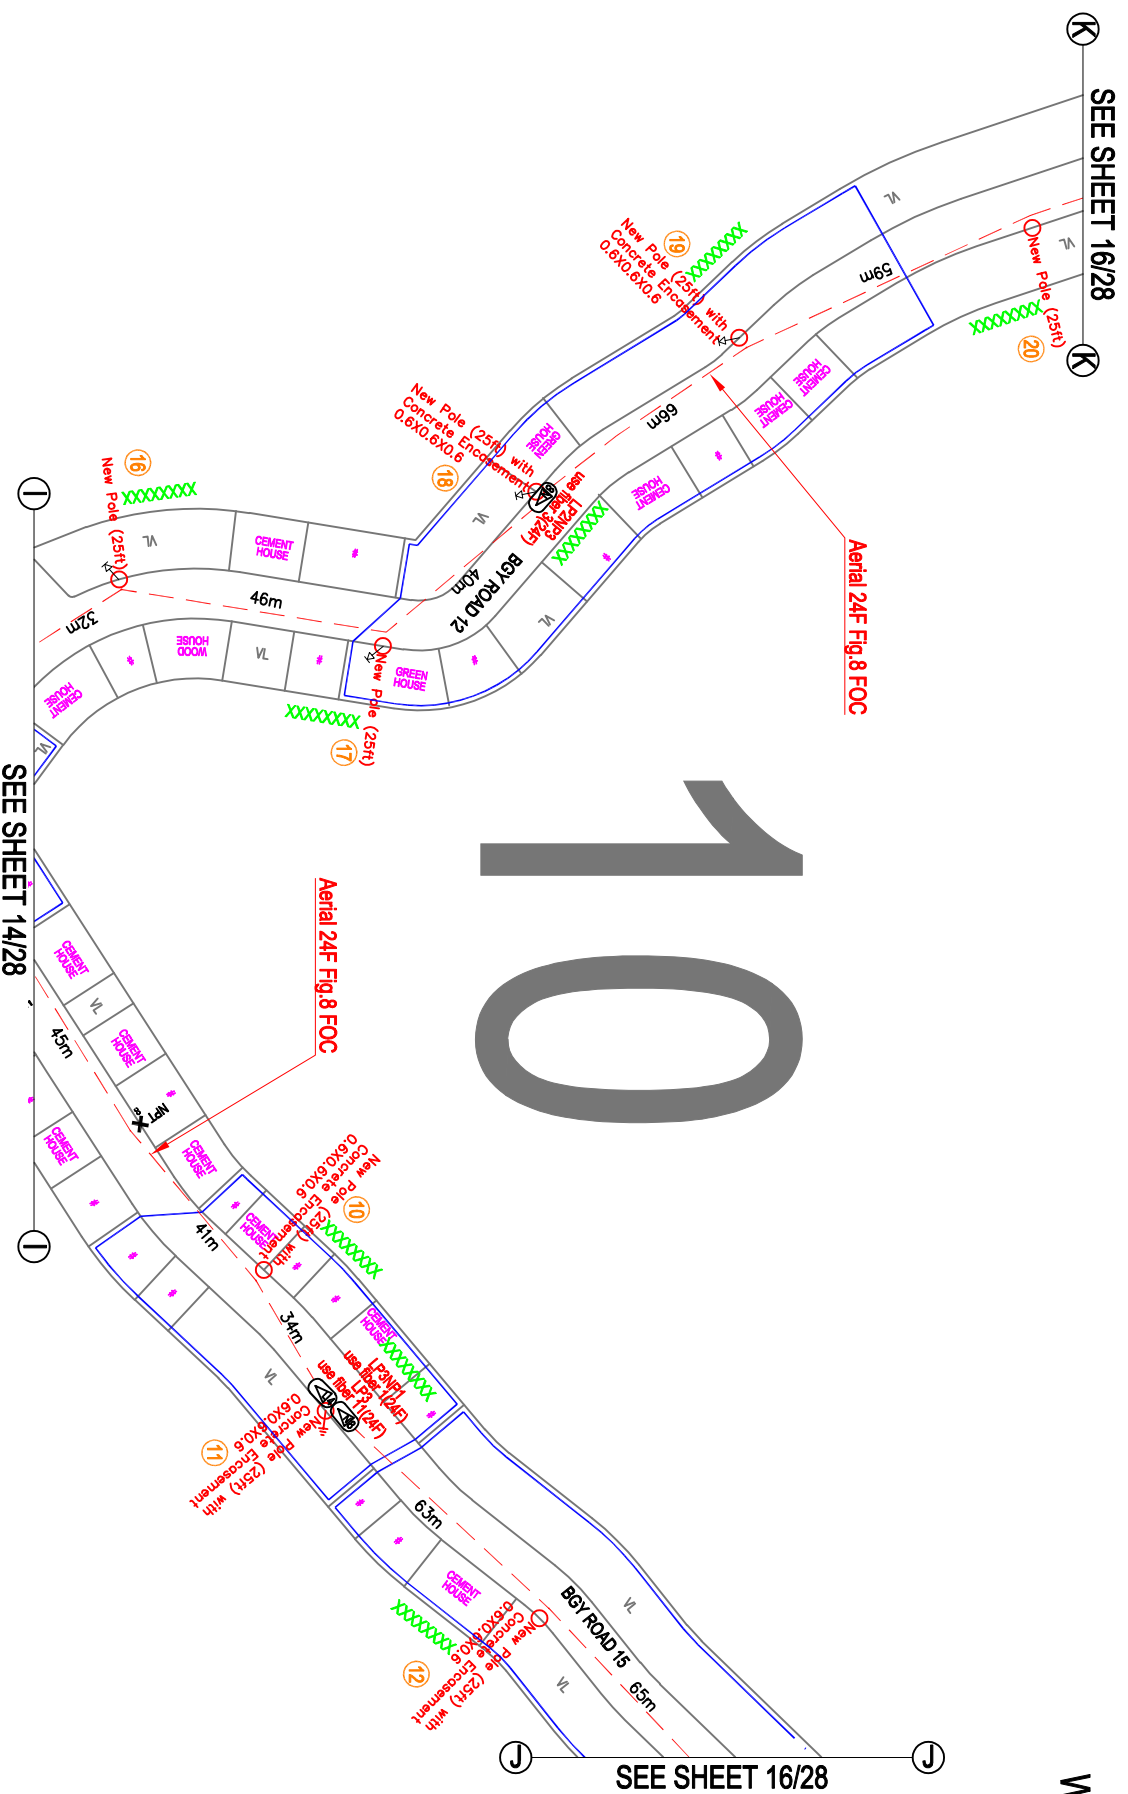

FTTH AS BUILT PLAN		COA/CONTRACT		CONTRACTOR		REGIONAL BGS / SALES(SME or HOME) TEAM		PROJECT DELIVERY TEAM		SHEET	
XXXX	CONTRACT SCHEDULE:	SOW		DRAWN BY:	CHECK BY:	CERTIFIED BY:	CERTIFIED BY:	APPROVED BY:	REVIEWED BY:	ENDORSED BY:	ACKNOWLEDGED BY:
WBS #:	ORIG. SCHED. START:		1		2	DESIGNER NAME	REGIONAL DESIGN DIVISION NAME	SALES	DEPARTMENT TEAM	APPROVED BY:	PROJECT BUSINESS NAME
	COMPLETION:		0		0						
XXXXXX	ACTUAL SCHED. START:		0		0						
	COMPLETION:		1		1						
	ACCEPTANCE DATE:		10		10						
EM-HEAD NAME		CON. FOC SPAN									
		SF FOC SPAN									

15/28



AS BUILT Plan of SAMPLE BARANGAY (16/28)

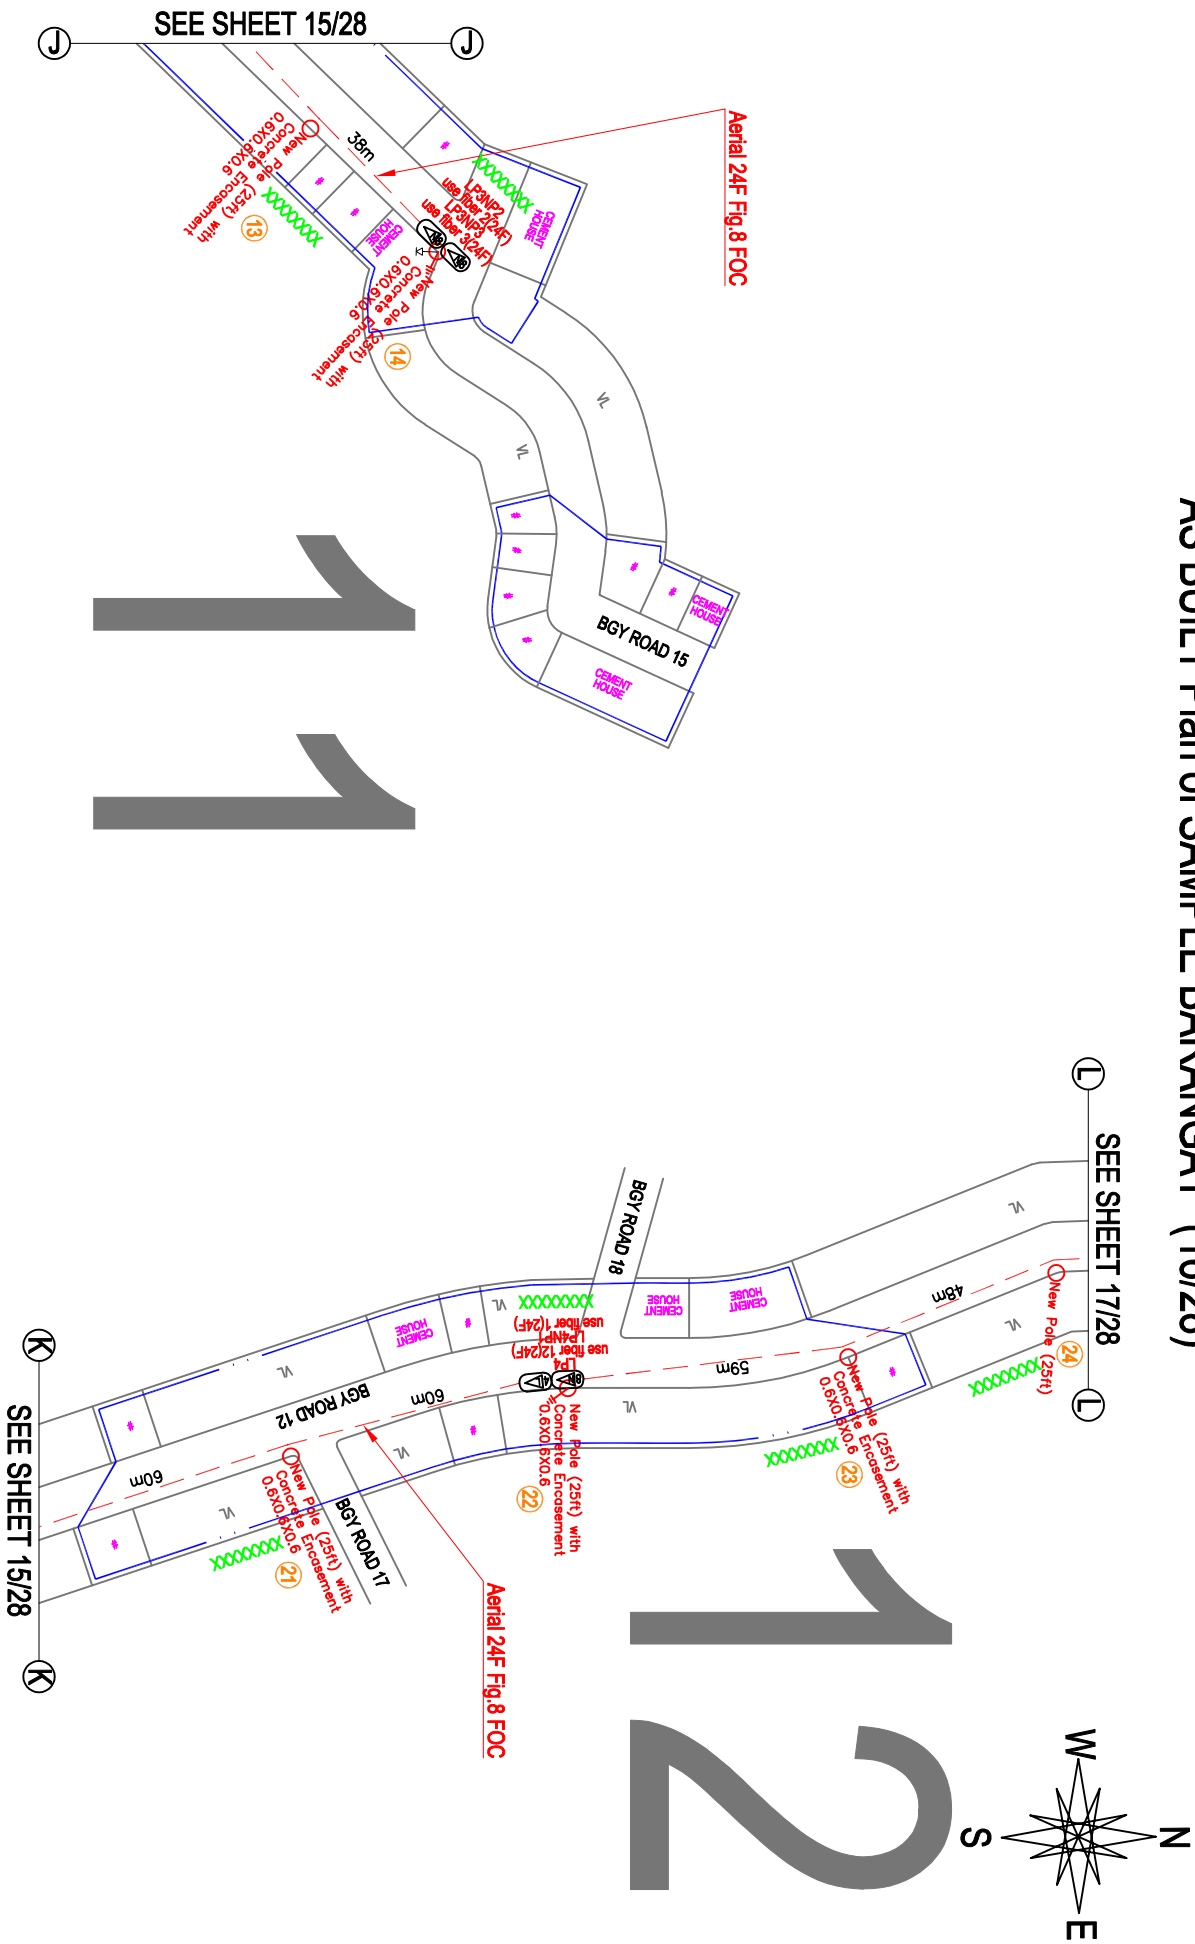

FTH AS BUILT PLAN		COA/CONTRACT		CONTRACTOR		REGIONAL BICS / SALES(SME or HOME) TEAM		PROJECT DELIVERY TEAM		SHEET		
XXXX WBS #: XXXXXX	CONTRACT SCHEDULE:	SOW	CONTRACTED	ACTUAL	DRAWN BY:	CHECK BY:	CERTIFIED BY:	CERTIFIED BY:	REVIEWED BY:	ENDORSED BY:	ACKNOWLEDGED BY:	DATE
	ORIGINAL SCHED:	 LCP	0	1	DESIGNER NAME	REGIONAL DESIGN LAWYER NAME	SALES	DEPARTMENT TEAM				16/28
	START:	 MAP	3	3								
	COMPLETION:	 FUTURE LCP	0	0	CERTIFIED BY:	CERTIFIED BY:	APPROVED BY:					
	ACTUAL SCHED:	 FUTURE MAP	0	0								
START:	NEW GROUNDING SYSTEM	1	1									
COMPLETION:	DOWN FOC SPAN	8	5									
ACCEPTANCE DATE:	SF FOC SPAN	0	0									
EIM-HEAD NAME					TELECOM ENGINEER NAME	CLIENT HEAD NAME	VSMSA COORDINATOR NAME	PROJECT ENGINEER NAME	TEAM LEADER NAME	DIVISION HEAD NAME		


AS BUILT Plan of SAMPLE BARANGAY (18/28)

SEE SHEET 13/28

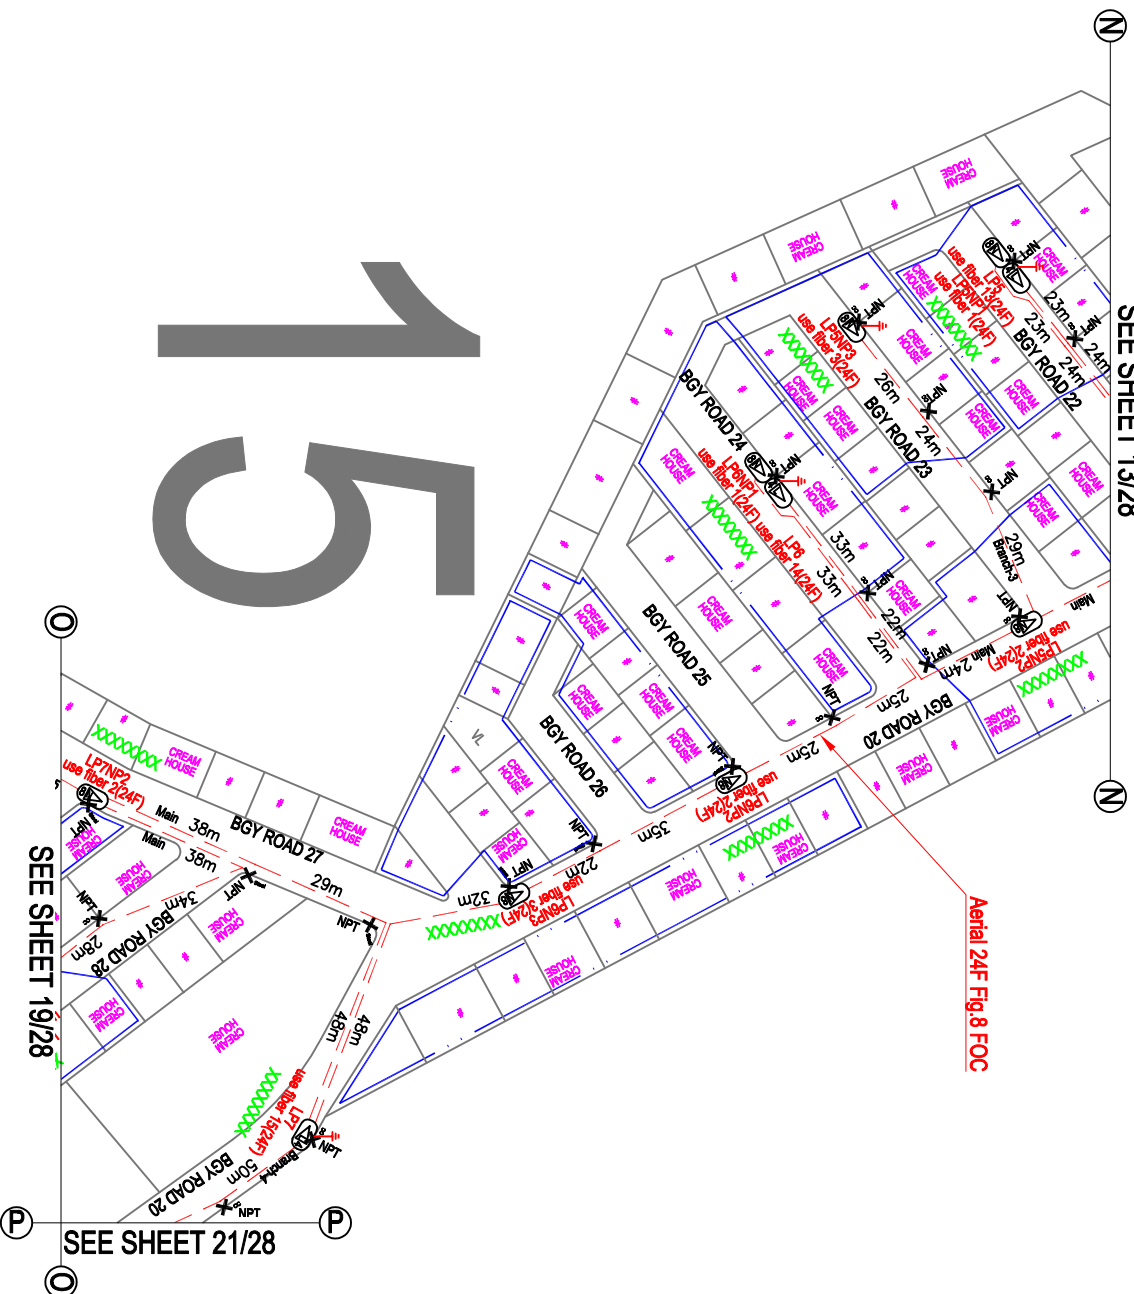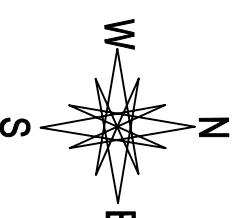

FTTH AS BUILT PLAN		COA/CONTRACT		CONTRACTOR		REGIONAL BICS / SALES(SME or HOME) TEAM		PROJECT DELIVERY TEAM		SHEET			
XXXX WBS #: XXXXXX	CONTRACT SCHEDULE:	SOW	CONTRACTED	ACTUAL	DRAWN BY:	CHECK BY:	CERTIFIED BY:	CERTIFIED BY:	APPROVED BY:	REVIEWED BY:	ENDORSED BY:	ACKNOWLEDGED BY:	DATE:
	ORIGINAL SCHED:	 LCP	1	3	DESIGNER NAME	REGIONAL DESIGN MANAGER NAME	SALES	DEPARTMENT TEAM	APPROVED BY:	PROJECT ENGINEER NAME	TEAM LEADER NAME	DIVISION HEAD NAME	18/ 28
	START COMPLETION:	 MAP	8	6									
	ACTUAL SCHED:	 FUTURE LCP	0	0	CERTIFIED BY:	CERTIFIED BY:	CERTIFIED BY:	CERTIFIED BY:	CERTIFIED BY:	CERTIFIED BY:	CERTIFIED BY:	CERTIFIED BY:	
	START COMPLETION:	 FUTURE MAP	0	0	CLUSTER HEAD NAME	WHSNS COORDINATOR							
ACCEPTANCE DATE:	 NEW GROUNDING SYSTEM	24	26										
EIM-HEAD NAME		 CON FOC SPAN	0	0									
		 SF FOC SPAN	0	0									



AS BUILT Plan of SAMPLE BARANGAY (19/28)

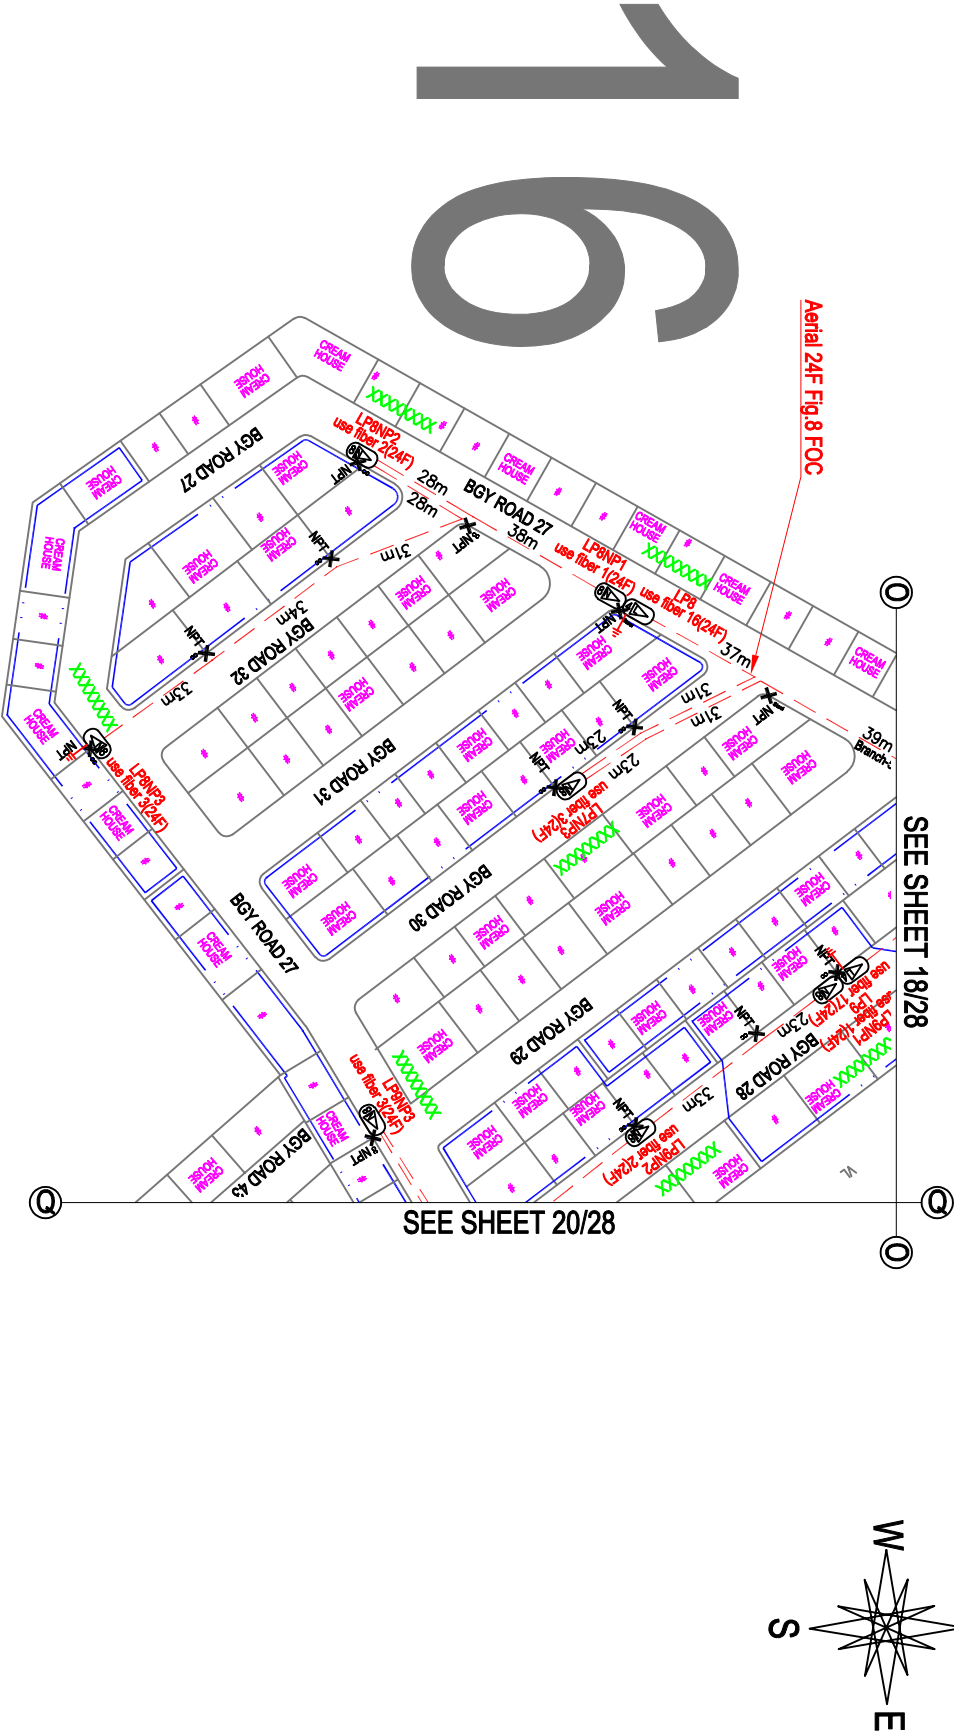


FTTH AS BUILT PLAN		COA/CONTRACT		CONTRACTOR		REGIONAL BICS / SALES(SME or HOME) TEAM		PROJECT DELIVERY TEAM		SHEET			
XXXX	CONTRACT SCHEDULE:	SOW	CONTRACTED	ACTUAL	DRAWN BY:	CHECK BY:	CERTIFIED BY:	CERTIFIED BY:	APPROVED BY:	REVIEWED BY:	ENDORSED BY:	ACKNOWLEDGED BY:	DATE:
WBS #:	ORIGINAL SCHED:	 LCP	2	2	DESIGNER NAME	REGIONAL DESIGN MANAGER NAME	SALES	DEPARTMENT TEAM	APPROVED BY:	PROJECT ENGINEER NAME	TEAM LEADER NAME	DMSION HEAD NAME	19/28
	START:	 MAP	7	7									
	COMPLETION:	 FUTURE LCP	0	0									
	ACTUAL SCHED:	 FUTURE MAP	0	0									
XXXXXX	START:	 NEW GROUNDING SYSTEM	3	3	CERTIFIED BY:	CERTIFIED BY:							
COMPLETION:	14		14										
ACCEPTANCE DATE:	0		0										
EIM-HEAD NAME		SF FOC SPAN			TELECOM ENGINEER NAME	CUSTOMER HEAD NAME	VISUALS COORDINATOR NAME						

AS BUILT Plan of SAMPLE BARANGAY (20/28)


SEE SHEET 21/28

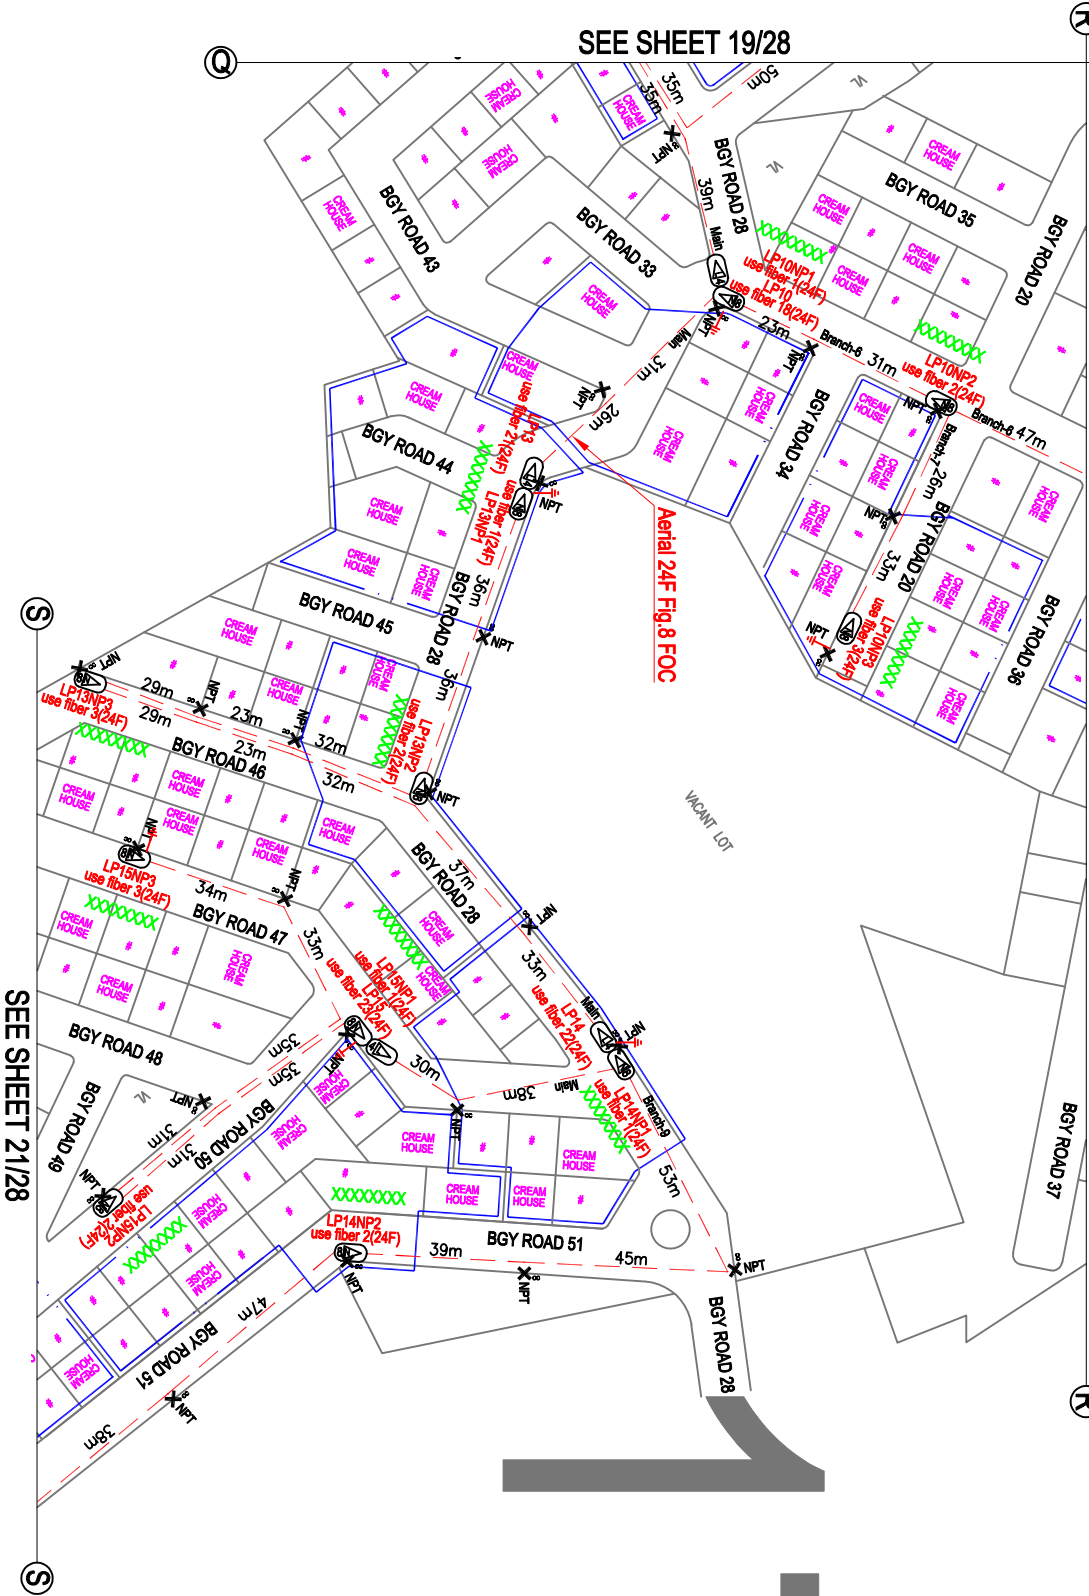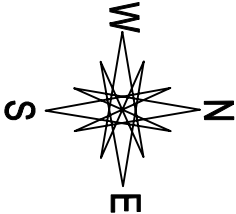


FTTH AS BUILT PLAN		COA/CONTRACT		CONTRACTOR		REGIONAL BICS / SALES(SME or HOME) TEAM		PROJECT DELIVERY TEAM		SHEET			
XXXXX WBS #: XXXXXX	CONTRACT SCHEDULE:	SOW	CONTRACTED	ACTUAL	DRAWN BY:	CHECK BY:	CERTIFIED BY:	CERTIFIED BY:	APPROVED BY:	REVIEWED BY:	ENDORSED BY:	ACKNOWLEDGED BY:	20/28 DATE:
	ORIGINAL SCHED:	 LCP	2	2	DESIGNER NAME	REGIONAL DESIGN MANAGER NAME	SALES	DEPARTMENT TEAM	APPROVED BY:	PROJECT ENGINEER NAME	TEAM LEADER NAME	DIVISION HEAD NAME	
	START:	 NCP	11	11									
	COMPLETION:	 FUTURE LCP	0	0	CERTIFIED BY:	CERTIFIED BY:							
	ACTUAL SCHED:	 FUTURE NCP	0	0									
	START:		0	0									
	COMPLETION:	 NEW GROUNDING SYSTEM	3	3									
	ACCEPTANCE DATE:	ODN FOC SPAN	36	36									
		SF FOC SPAN	0	0									
EIM-HEAD NAME													

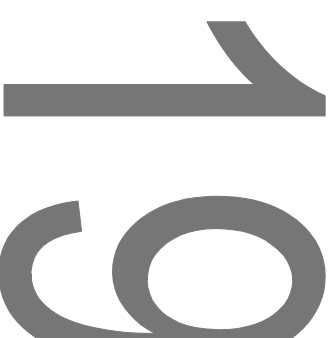[illegible]

AS BUILT Plan of SAMPLE BARANGAY (22/28)

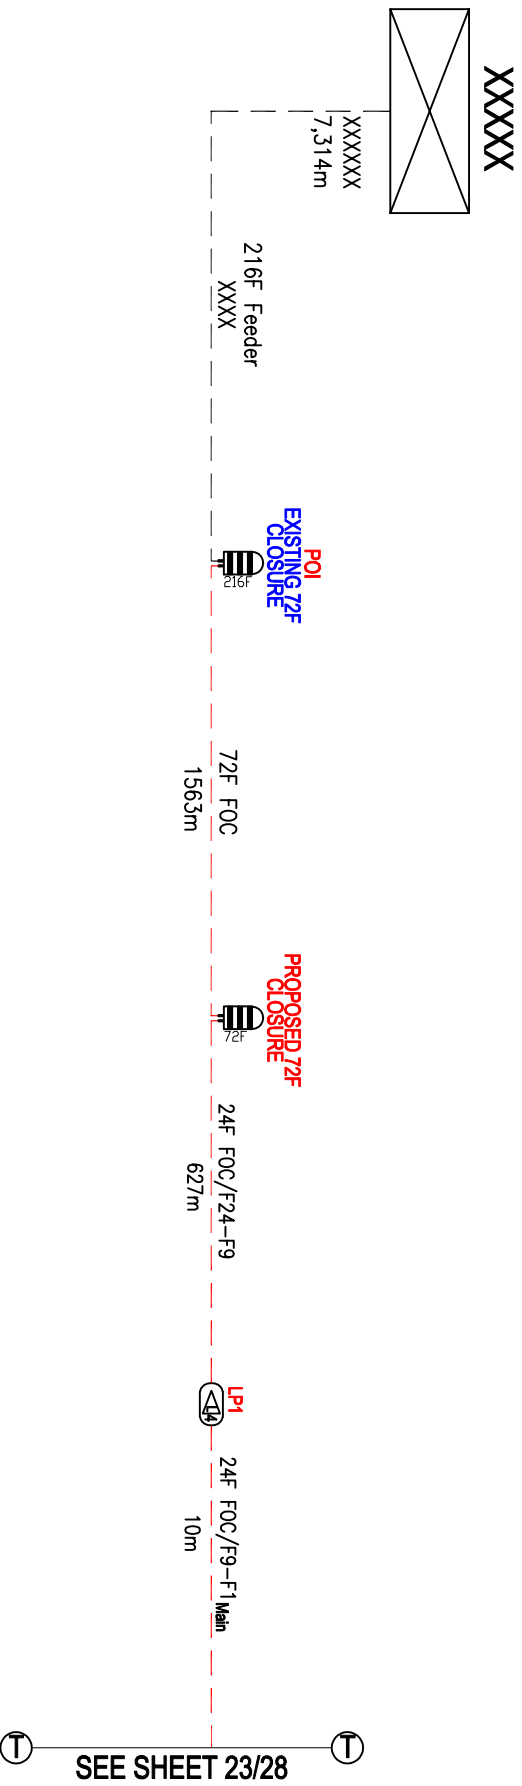[illegible]

AS BUILT Plan of SAMPLE BARANGAY (23/28)

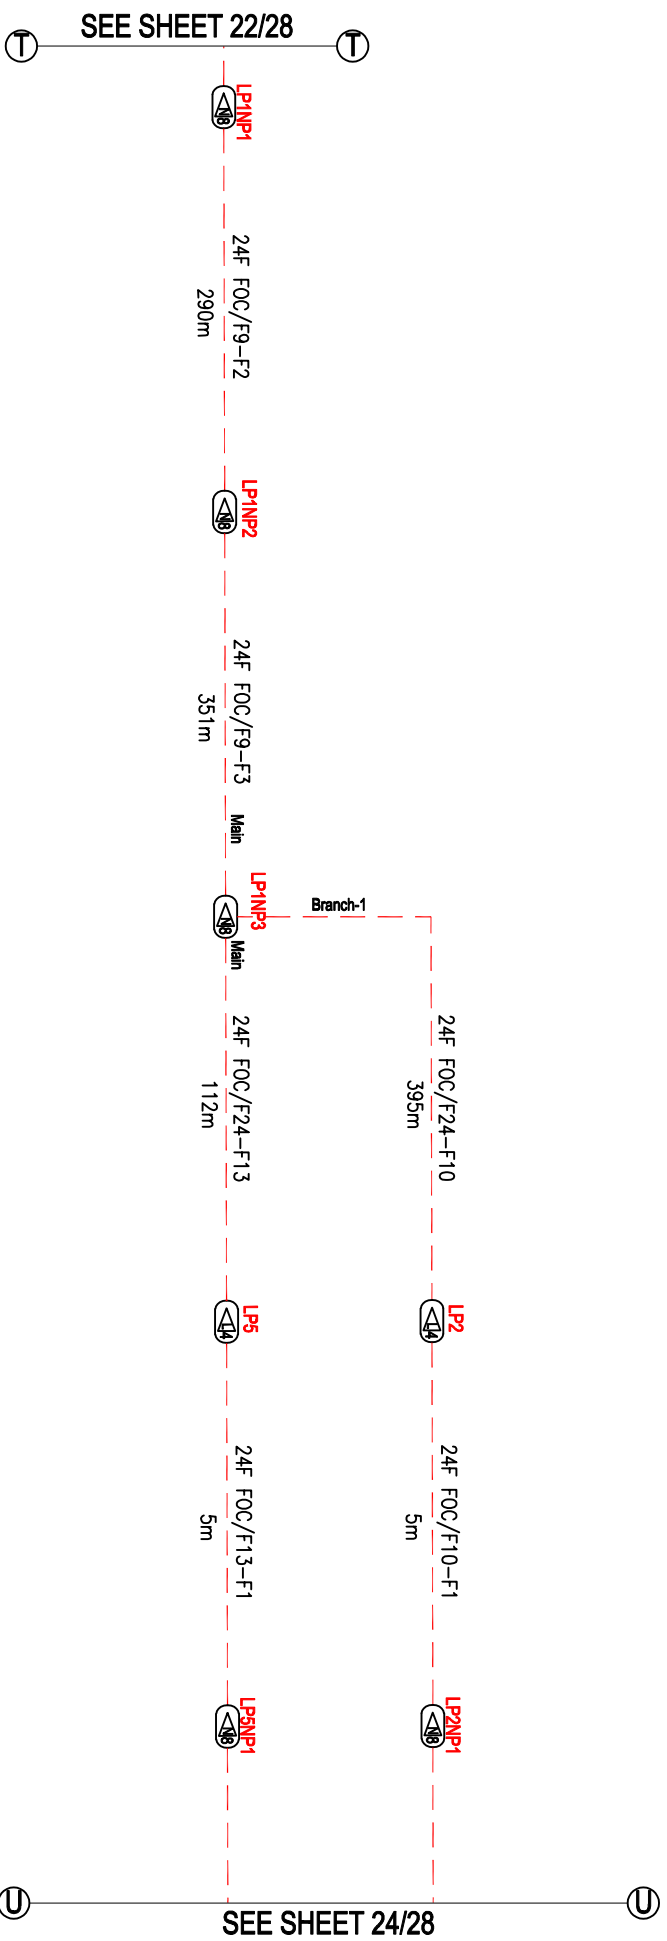


FTTH AS BUILT PLAN		COA/CONTRACT		CONTRACTOR		REGIONAL BROS / SALES/SMR or HOME TEAM		PROJECT DELIVERY TEAM		SHEET			
XXXXX	CONTRACT SCHEDULE:	SOW	CONTRACTED	ACTUAL	DRAWN BY:	CHECK BY:	CERTIFIED BY:	CERTIFIED BY:	APPROVED BY:	REVIEWED BY:	ENDORSED BY:	ACKNOWLEDGED BY:	
	ORIG. SCHED. START:		LOP	15	15								
	COMPLETION:		NAP	44	44								
	FUTURE LOP START:		FUTURE LOP	0	0								
XXXXXXX	ACTUAL SCHED. START:		FUTURE NAP	0	0								
	COMPLETION:		NEW GROUNDING SYSTEM	30	30								
	ACCEPTANCE DATE:		CON. FOC SPAN	146	141								
			SF FOC SPAN	41	37								
EIM-HEAD NAME													

23/28


DATE:

AS BUILT Plan of SAMPLE BARANGAY (24/28)

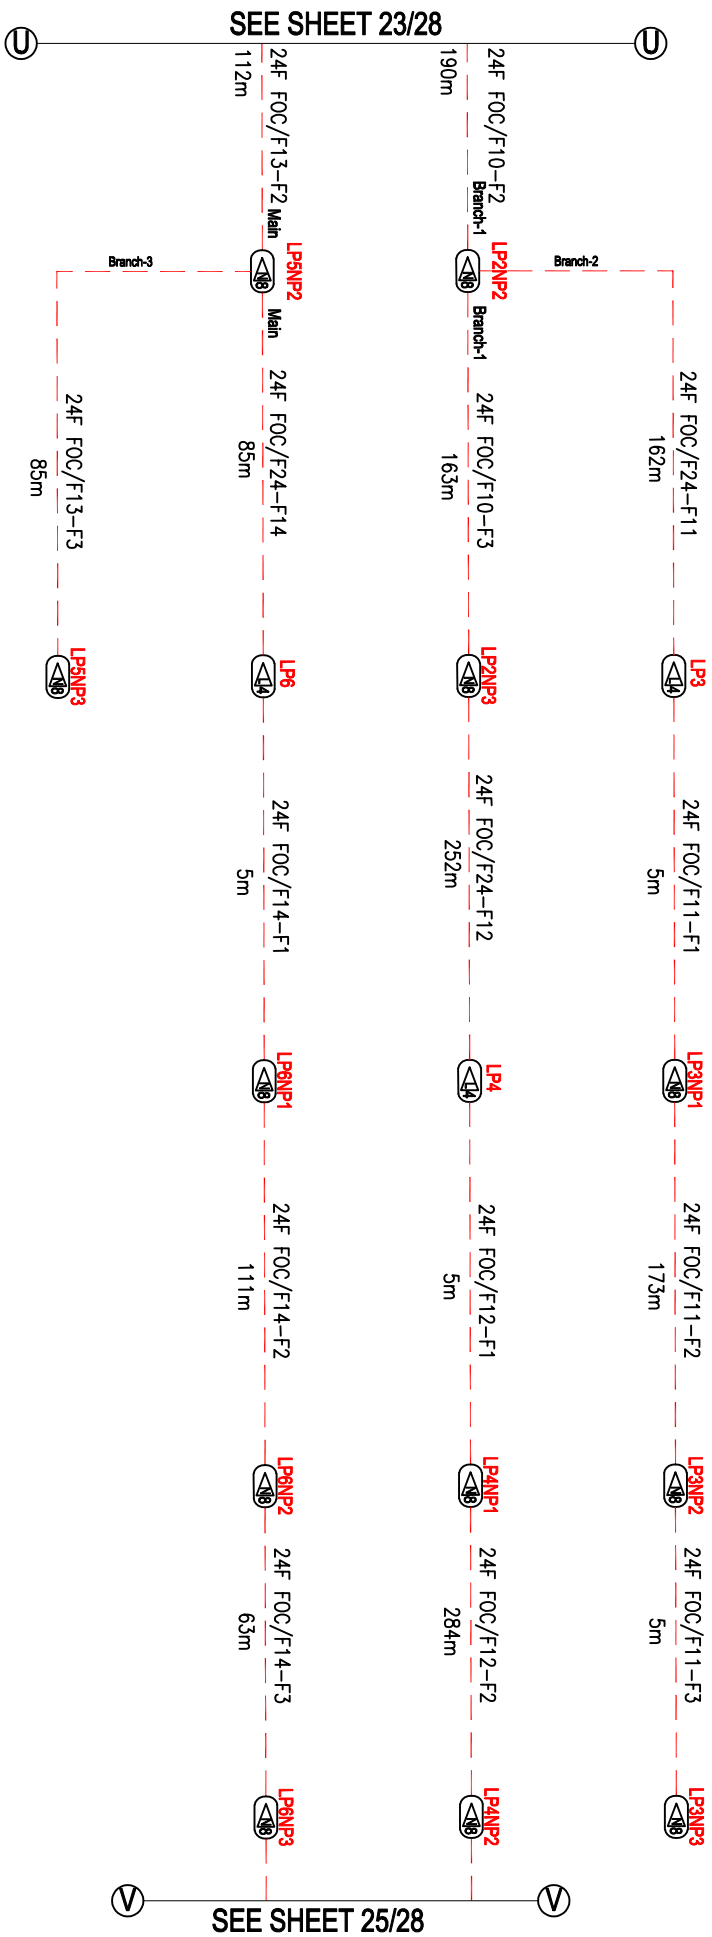


FTTH AS BUILT PLAN		COA/CONTRACT		CONTRACTOR		REGIONAL BCS / SALES/SMC or HOME TEAM			PROJECT DELIVERY TEAM			SHEET
XXXX	CONTRACT SCHEDULE:	SOW		DRAWN BY:	CHECK BY:	CERTIFIED BY:	CERTIFIED BY:	APPROVED BY:	REVIEWED BY:	ENDORSED BY:	ACKNOWLEDGED BY:	
WBS #:	ORIGINAL SCHED: START: COMPLETION: ACTUAL SCHED: START: COMPLETION:	15 44 0 0	15 44 0 0	DESIGNER NAME		SALES		DEPARTMENT TEAM		PROJECT ENGINEER NAME		TEAM LEADER NAME
XXXXXX	FUTURE LCP FUTURE MAP NEW GROUNDING SYSTEM OPN FOC SPAN SF FOC SPAN	0 0 30 146 41	0 0 30 141 37	REGIONAL DESIGN MANAGER NAME								DIVISION HEAD NAME
ENH-HEAD NAME	ACCEPTANCE DATE:			TELECOM ENGINEER NAME		CLUSTER HEAD NAME		VENDOR COORDINATOR NAME		DATE:		24/28

AS BUILT Plan of SAMPLE BARANGAY (25/28)

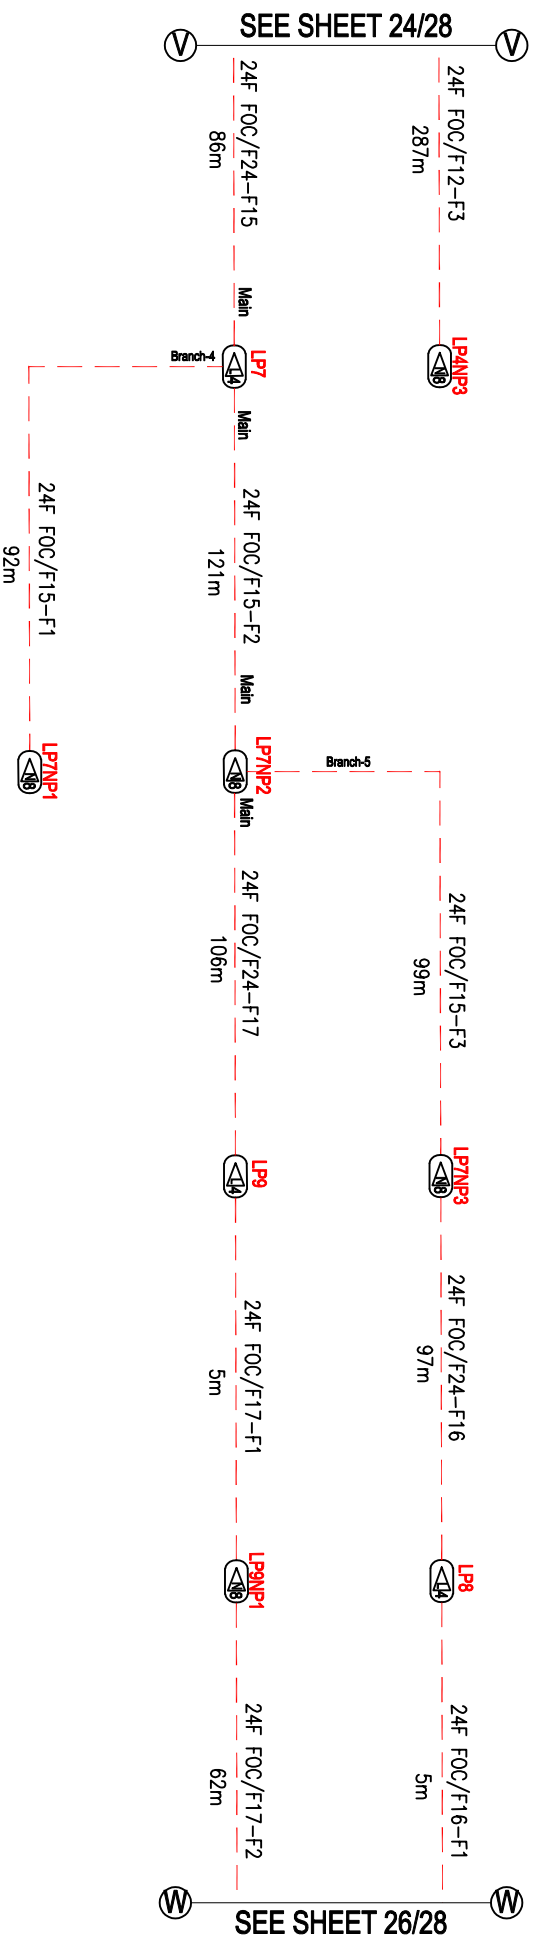


FTTH AS BUILT PLAN		COA/CONTRACT		CONTRACTOR		REGIONAL BCS / SALES(SME or HOME) TEAM		PROJECT DELIVERY TEAM		SHEET					
CONTRACT SCHEDULE:		DRAWN BY:		CHECK BY:		CERTIFIED BY:		CERTIFIED BY:		REVIEWED BY:	ENDORSED BY:	ACKNOWLEDGED BY:			
XXXX	ORIGINAL SCHED:	15	15			SALES									
WBS #:	START COMPLETION:	15	15												
XXXXXX	FUTURE LOP	0	0												
	ACTUAL SCHED:	0	0												
	COMPLETION:	30	30												
	CON. DATE:	146	141												
	CON. FOR SPAN	41	37												
	SF FOR SPAN	41	37												
EIM-HEAD NAME						TELECOM ENGINEER NAME		CUSTOMER HEAD NAME		NCS&S COORDINATOR NAME		PROJECT ENGINEER NAME	TEAM LEADER NAME	DIVISION HEAD NAME	DATE:

AS BUILT Plan of SAMPLE BARANGAY (26/28)

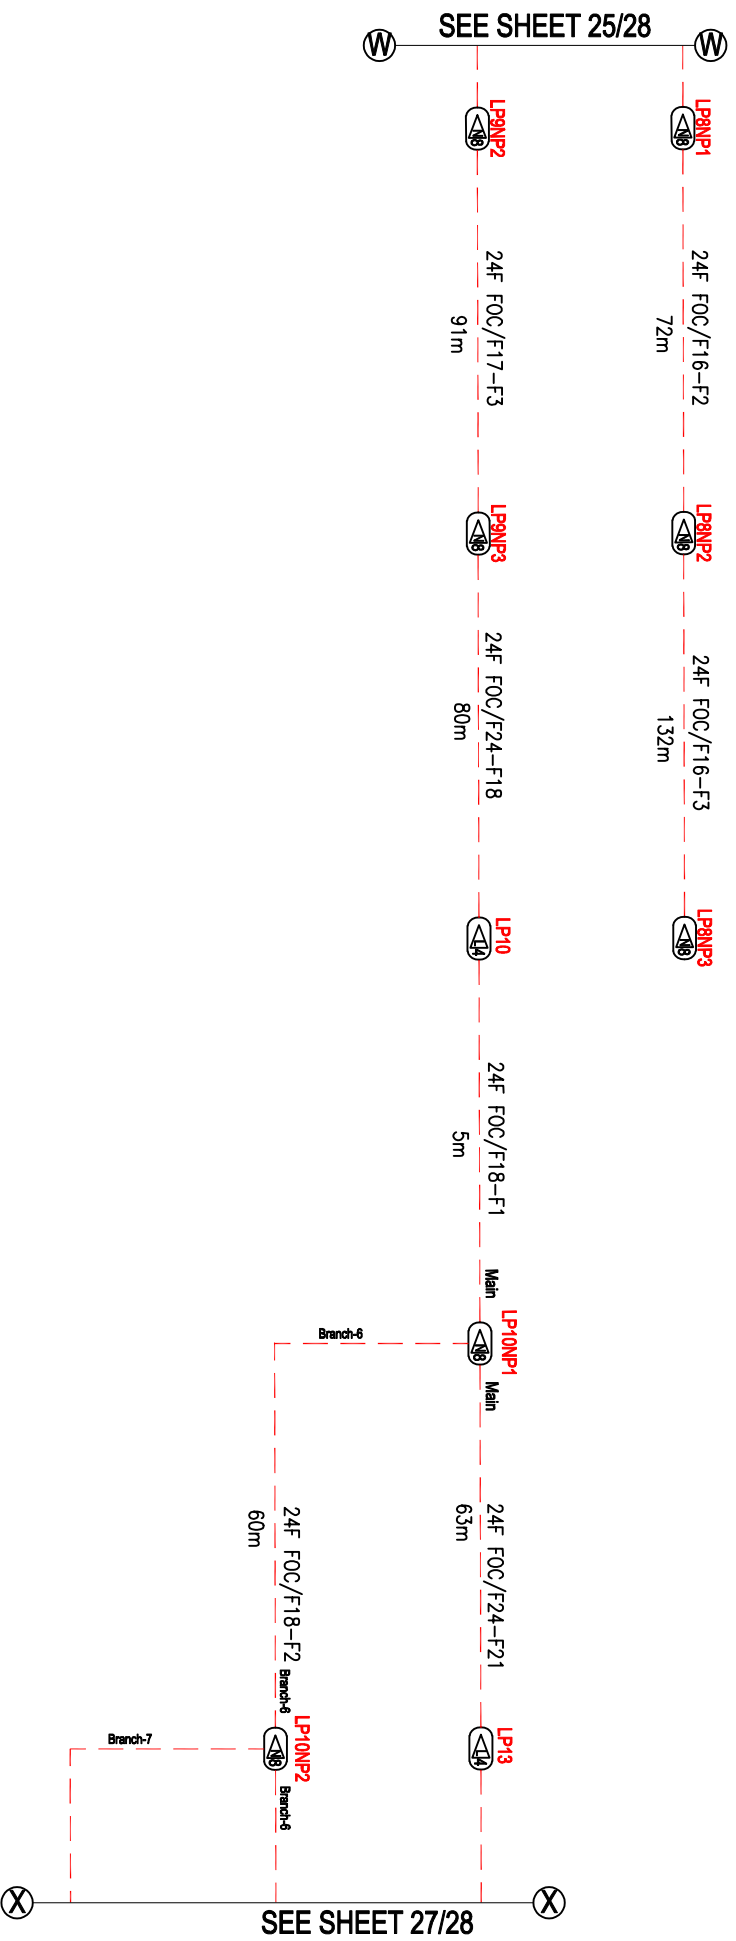

FTTH AS BUILT PLAN		COA/CONTRACT		CONTRACTOR		REGIONAL BROS / SALES(SM or HOME) TEAM		PROJECT DELIVERY TEAM		SHEET			
XXXX WBS #: XXXXXX	CONTRACT SCHEDULE:		SOW	CONTRACTED	ACTUAL	DRAWN BY:	CHECK BY:	CERTIFIED BY:	CERTIFIED BY:	APPROVED BY:	REVIEWED BY:	ENDORSED BY:	ACKNOWLEDGED BY:
	ORIGINAL SCHED. START:	10-2	LOP	15	15								
	COMPLETION:	10-2	MAP	44	44	DESIGNER NAME	REGIONAL DESIGN MANAGER NAME						
	FUTURE SCHED. START:	10-2	FUTURE LOP	0	0	DEPARTMENT TEAM							
	COMPLETION:	10-2	FUTURE MAP	0	0								
ACTUAL SCHED. START:	10-2	NEW GROUNDING SYSTEM	30	30	CERTIFIED BY:	CERTIFIED BY:	APPROVED BY:	PROJECT ENGINEER NAME	TEAM LEADER NAME	DIVISION HEAD NAME	DATE:		
ACCEPTANCE DATE:	10-2	CON. FOR SPAN	146	141	TELECOM ENGINEER NAME	CLUSTER HEAD NAME	VENUE COORDINATOR NAME						
EM-H-HEAD NAME		ST FOR SPAN	41	37									

AS BUILT Plan of SAMPLE BARANGAY (28/28)

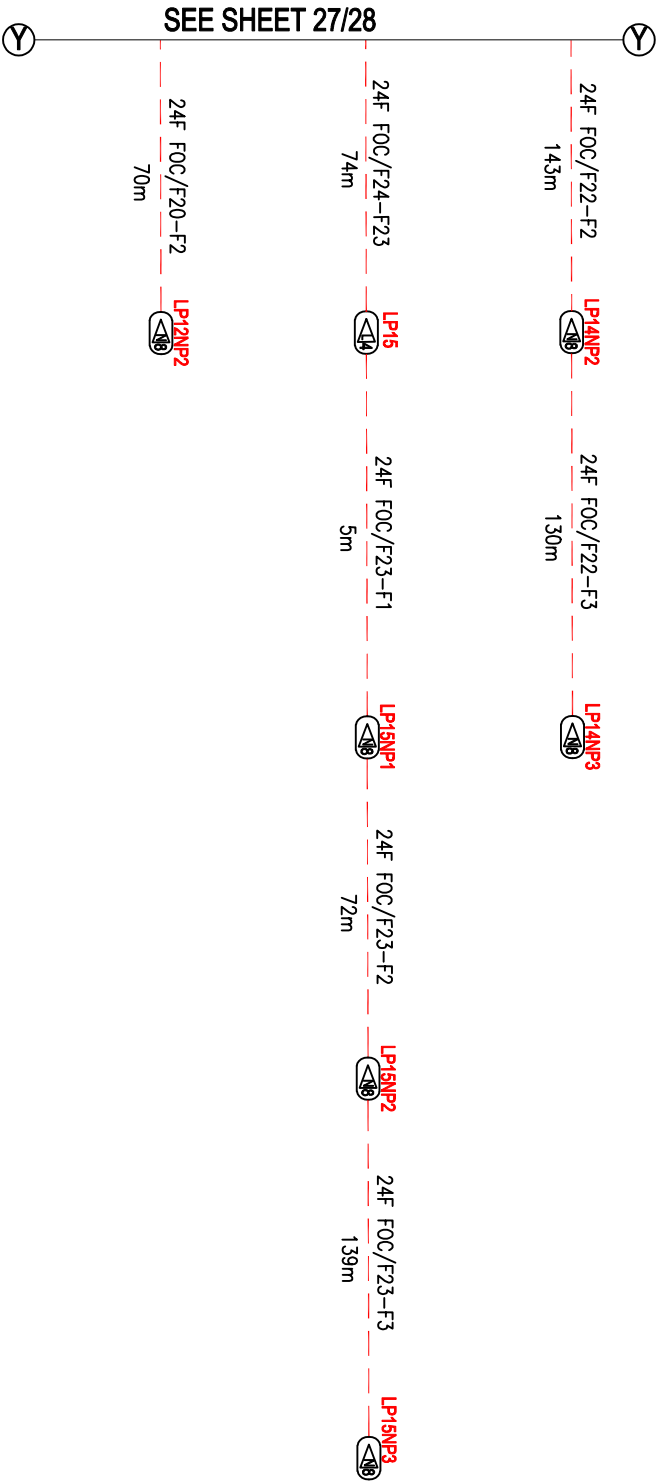

FTTH AS BUILT PLAN		COA/CONTRACT		CONTRACTOR		REGIONAL BICS / SALES(SME or HOME) TEAM			PROJECT DELIVERY TEAM			SHEET												
XXXX		CONTRACT SCHEDULE:		SOW		CONTRACTED		ACTUAL		DRAWN BY:		CHECK BY:		CERTIFIED BY:	CERTIFIED BY:	APPROVED BY:	REVIEWED BY:	ENDORSED BY:	ACKNOWLEDGED BY:	DATE:				
WBS #:		ORIGINAL SCHED:		LCP		15		15		DESIGNER NAME		REGIONAL DESIGN MANAGER NAME		SALES		DEPARTMENT TEAM		PROJECT ENGINEER NAME		TEAM LEADER NAME		DMS/CM HEAD NAME		28/28
XXXXXX		START: COMPLETION:		LCP		0		0		NEW GROUNDING SYSTEM		NEW FOC SPAN		CERTIFIED BY:		APPROVED BY:		PROJECT ENGINEER NAME		TEAM LEADER NAME		DMS/CM HEAD NAME		28/28
EIM-HEAD NAME		ACCEPTANCE DATE:		NEW FOC SPAN		146		141		TELECOM ENGINEER NAME		CUSTOMER HEAD NAME		VENDOR COORDINATOR NAME		PROJECT ENGINEER NAME		TEAM LEADER NAME		DMS/CM HEAD NAME		DATE:		28/28