AS BUILT of UPLINK-FEEDER (1/15)

FTTH Symbols

Dome-Type Closure (xFibers)	LOOP 5m (FOR FUTURE LCP/NAP/BRANCHING)
LCP (1:8)	Grounding System
Double NAP(2 x 1:8)	Extended messenger wire
NAP (1:8)	NPT — No Pole Tags
Future LCP (1:8)	T — Transformer
Future NAP (1:8)	D — Danger
Future NAP (1:8), 2nd splitter for future	DA — Don't Attach
DIGITEL/SMART Pole	#2 — Occupied House Number
PLDT Pole (Cirular Conc.)	# — Occupied House no number
PLDT Pole (Wooden)	2V — Vacant Lot Number
Electric Pole (Conc. Square)	VL — Vacant Lot no number
Electric Pole (Conc. Circular)	Existing SIDE GUY
Electric Pole (Wooden)	Proposed DOWN SIDE GUY
Electric Pole (Steel)	Proposed SIDEWALK, SIDE GUY WITH ANCHOR
PT&T Pole	FOC (Aerial Installation)
Manhole	FOC (Underground Installation)

New Pole

Proposed ODF

CONTROL NUMBER:
NOTES:

Homing Exchange	----
FEEDER CABLE ID 216F	–
SUBFEEDER CABLE ID 72F	–
SUBFEEDER CABLE ID 72F	–
TOTAL CABLE LENGTH–Feeder(Aerial 216F Fig.8 FOC)	730m
TOTAL CABLE LENGTH–Feeder(UG 216F Fig.8 FOC)	67m
TOTAL CABLE LENGTH–Subfeeder(72F)	3,840m
24F ODF	1
216F Closure	1
72F Closure	2
New Pole 25ft (Mechanical)	26
New Pole 30ft (Mechanical)	4
CONCRETE ENCASEMENT	23
Proposed DOWN SIDE GUY	23
Proposed SIDEWALK, SIDE GUY WITH ANCHOR	5
Two (2) HDPE Pipe 50mm Ø	50m
GI Pipe (114mm Ø x 3m) – Vertical	1

MUNICIPALITY:
PROVINCE:
BARANGAY:

POI Information	
Homing Exchange	----
Feeder Cable ID 216F	–
Subfeeder Cable ID 72F	–
Subfeeder Cable ID 72F	–
Core Assignment	–

POINT	LOCATION
POINT A	FL10 CABINET
POINT B	PROPOSED 216F CLOSURE
POINT C	PROPOSED 72F CLOSURE
POINT D	PROPOSED 72F CLOSURE

FEEDER AS BUILT PLAN

WBS #:

AS BUILT Of UPLINK-FEEDER

EIM-HEAD

COA/CONTRACT

CONTRACT SCHEDULE:

ORIGINAL SCHED:
START:
COMPLETION:

ACTUAL SCHED:
START:
COMPLETION:

ACCEPTANCE DATE:

SOW	CONTRACTED	ACTUAL
72F ODF	1	1
216F CLOSURE	1	1
72F CLOSURE	2	2
NEW GROUNDING SYSTEM	16	14

CONTRACTOR

DRAWN BY:	CHECK BY:

VIS-CFAO TEAM

NOTED BY:	NOTED BY:	APPROVED BY:
VisFFS3	Coordinator – VisFFS3	HEAD VisFFS

VISAYAS FIXED PROJECT MANAGEMENT TEAM

REVIEWED BY:	ENDORSED BY:	ACKNOWLEDGED BY:
PROJECT ENGINEER	TEAM LEADER	DIVISION OPPM HEAD


SHEET

1/15

DATE:


AS BUILT of UPLINK-FEEDER (2/15)

VICINITY MAP

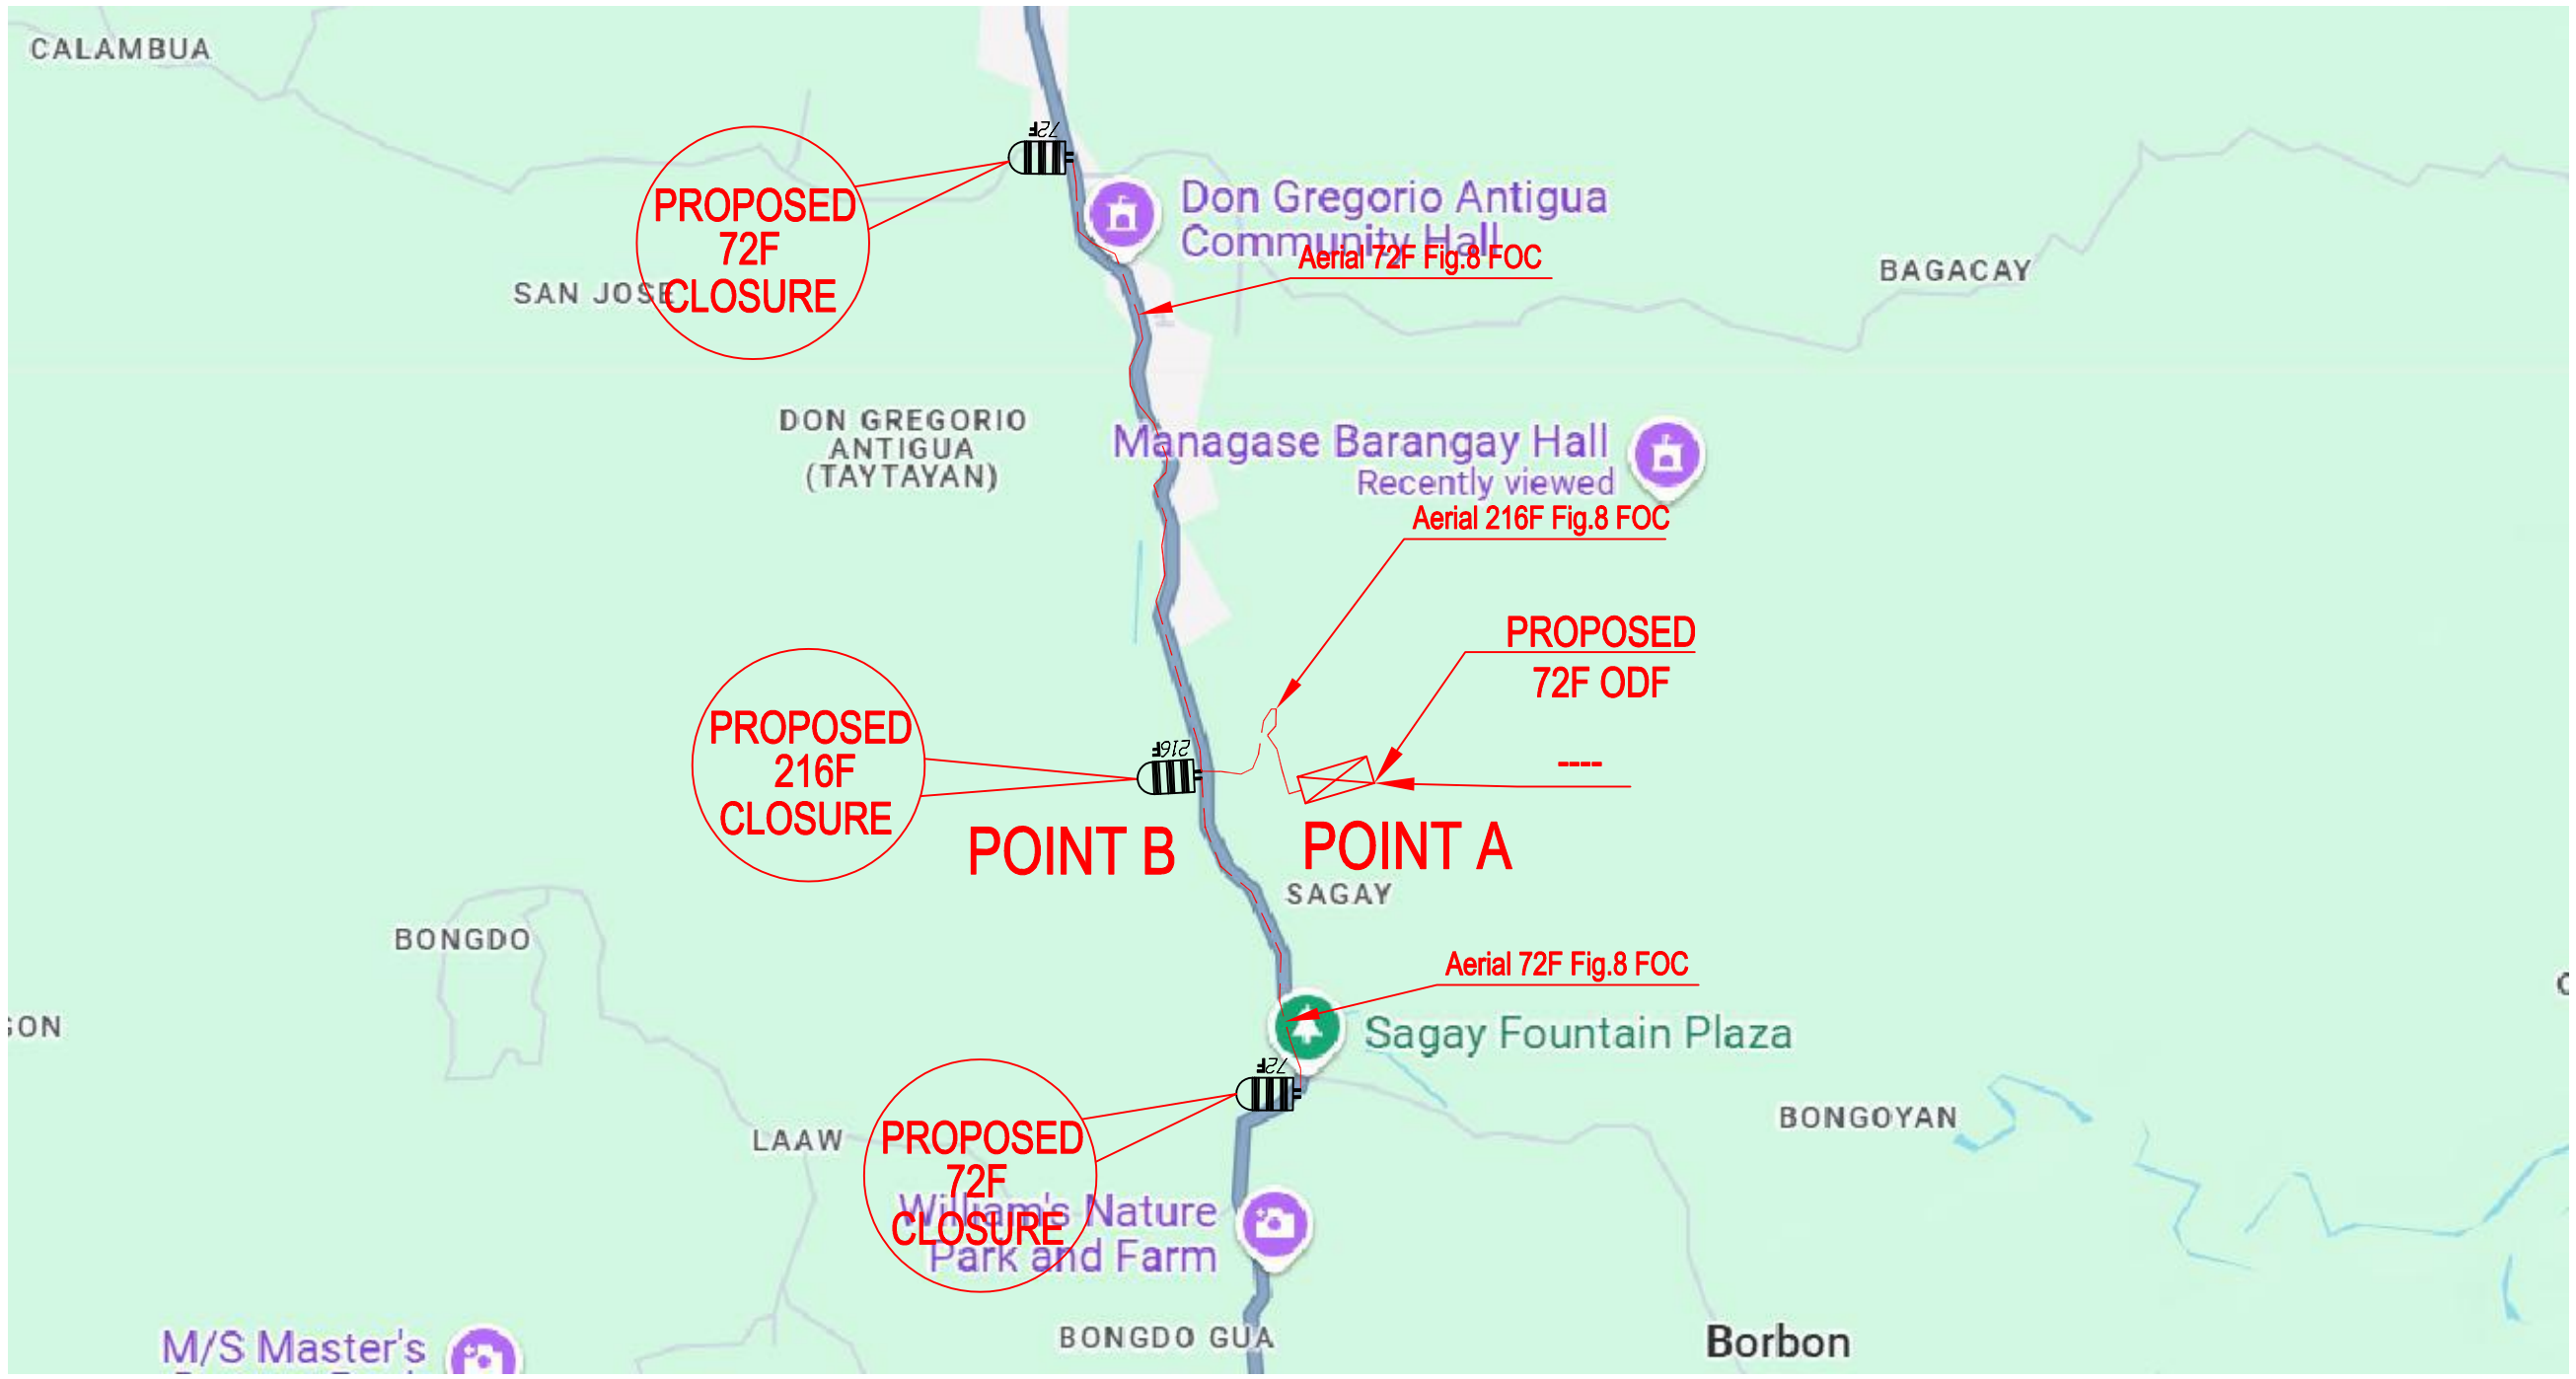


FEEDER AS BUILT PLAN		COA/CONTRACT			CONTRACTOR		VIS-CFAO TEAM			VISAYAS FIXED PROJECT MANAGEMENT TEAM			
	----	CONTRACT SCHEDULE:	SOW	CONTRACTED ACTUAL	DRAWN BY:	CHECK BY:	NOTED BY:	NOTED BY:	APPROVED BY:	REVIEWED BY:	ENDORSED BY:	ACKNOWLEDGED BY:	SHEET
	WBS #:	ORIGINAL SCHED:	72F ODF	1 1									
	AS BUILT Of UPLINK-FEEDER	START:											
		COMPLETION:	216F CLOSURE	1 1									
		ACTUAL SCHED:											
		START:	72F CLOSURE	2 2									2/15
		COMPLETION:											
		ACCEPTANCE DATE:	NEW GROUNDING SYSTEM	16 14									
	EIM-HEAD						VisFFS3	Coordinator - VisFFS3	HEAD VisFFS	PROJECT ENGINEER	TEAM LEADER	DIVISION OPPM HEAD	DATE:

AS BUILT of UPLINK-FEEDER (3/15)

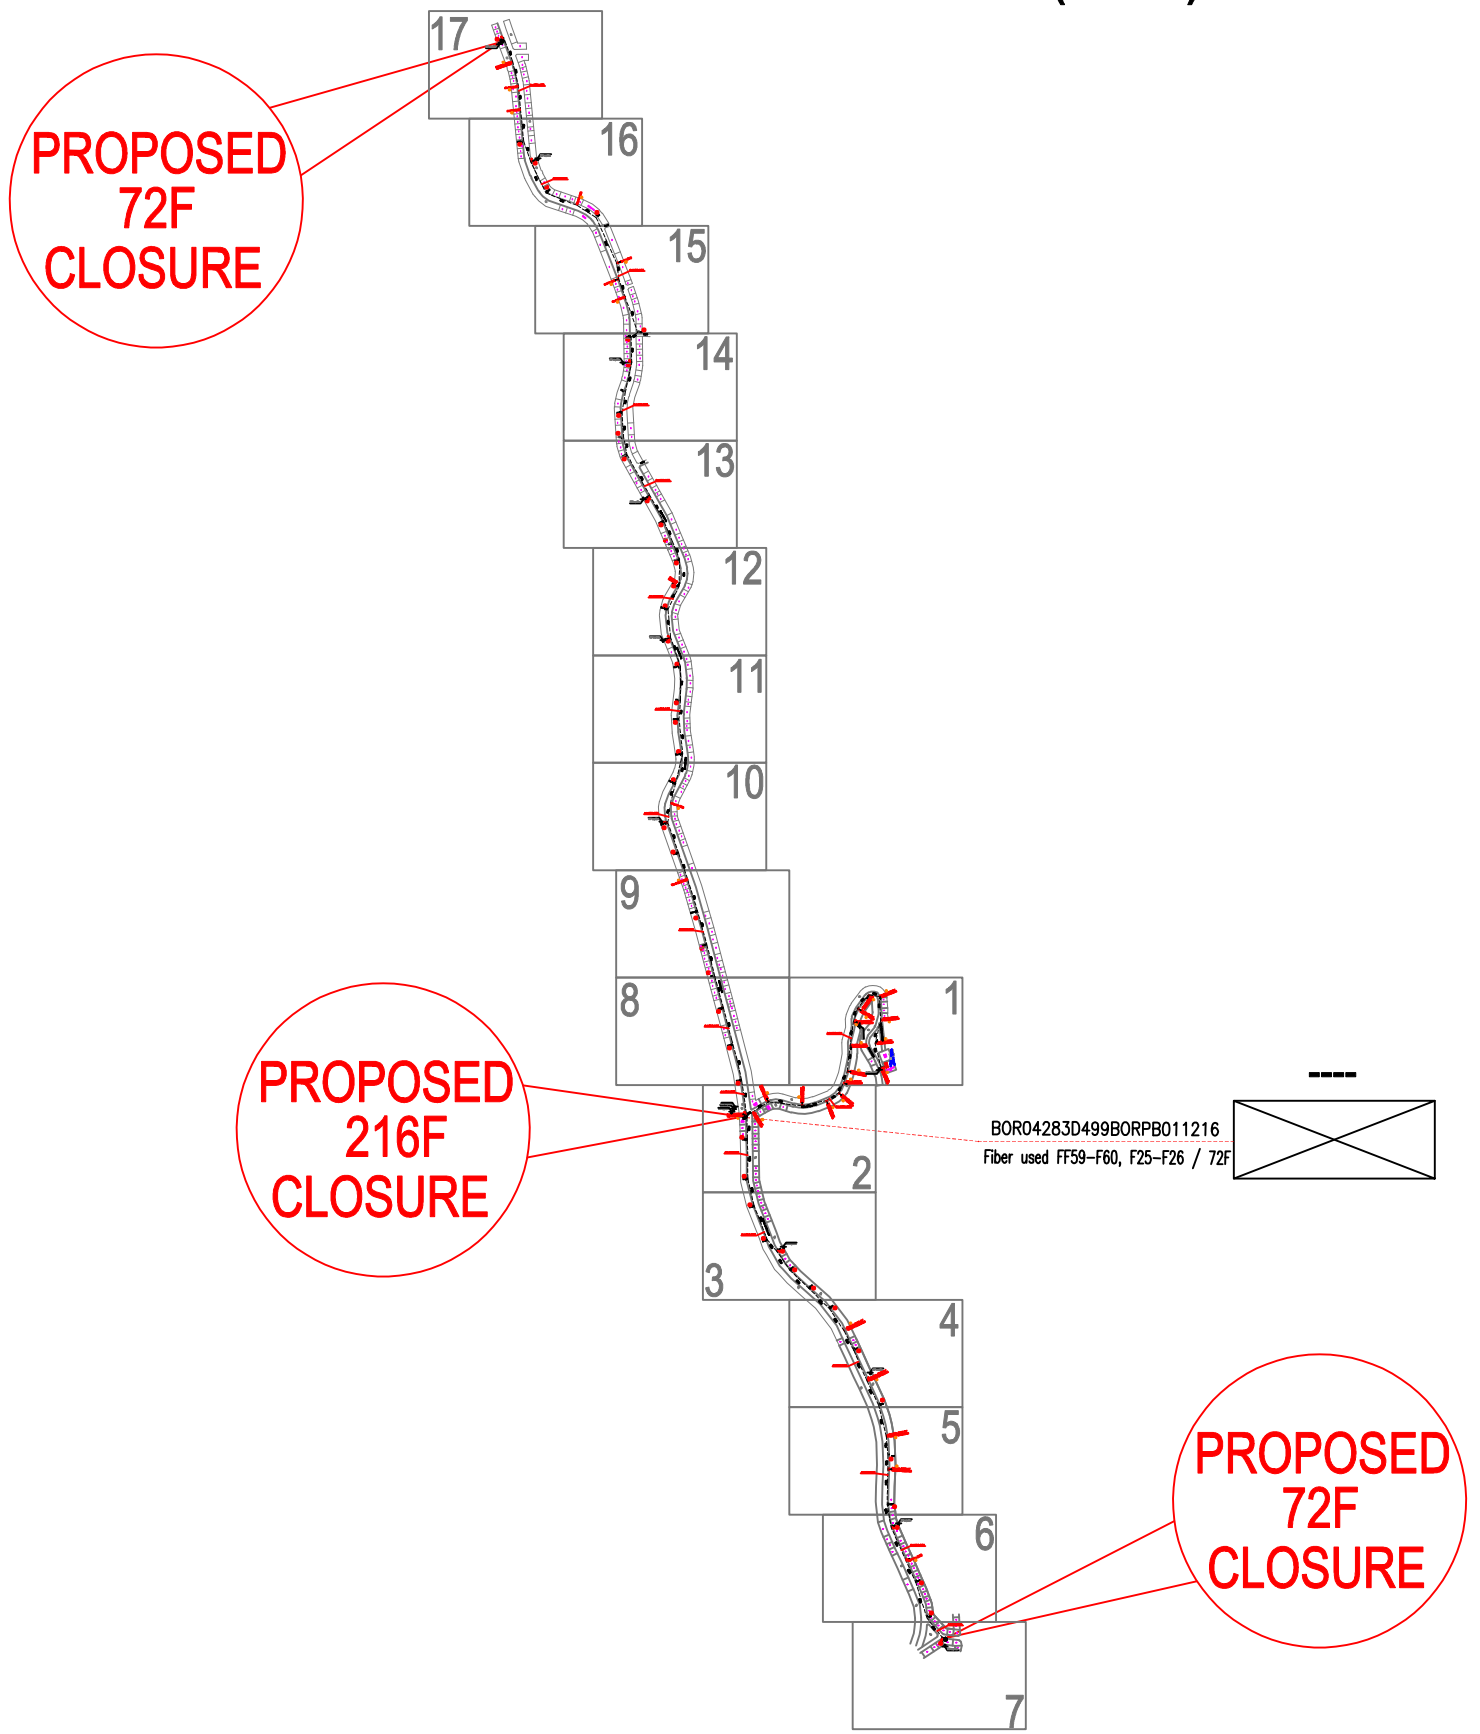

FEEDER AS BUILT PLAN		COA/CONTRACT			CONTRACTOR		VIS-CFAO TEAM			VISAYAS FIXED PROJECT MANAGEMENT TEAM			
	----	CONTRACT SCHEDULE:	SOW	CONTRACTED / ACTUAL	DRAWN BY:	CHECK BY:	NOTED BY:	NOTED BY:	APPROVED BY:	REVIEWED BY:	ENDORSED BY:	ACKNOWLEDGED BY:	SHEET
	WBS #:	ORIGINAL SCHED:	72F ODF	1 / 1									
	AS BUILT Of UPLINK-FEEDER	START:											
		COMPLETION:	216F CLOSURE	1 / 1									
		ACTUAL SCHED:											
		START:											
		COMPLETION:	72F CLOSURE	2 / 2									3/15
		ACCEPTANCE DATE:											
	EIM-HEAD		NEW GROUNDING SYSTEM	16 / 14			VisFFS3	Coordinator - VisFFS3	HEAD VisFFS	PROJECT ENGINEER	TEAM LEADER	DIVISION OPPM HEAD	DATE:


AS BUILT of UPLINK-FEEDER (4/15)

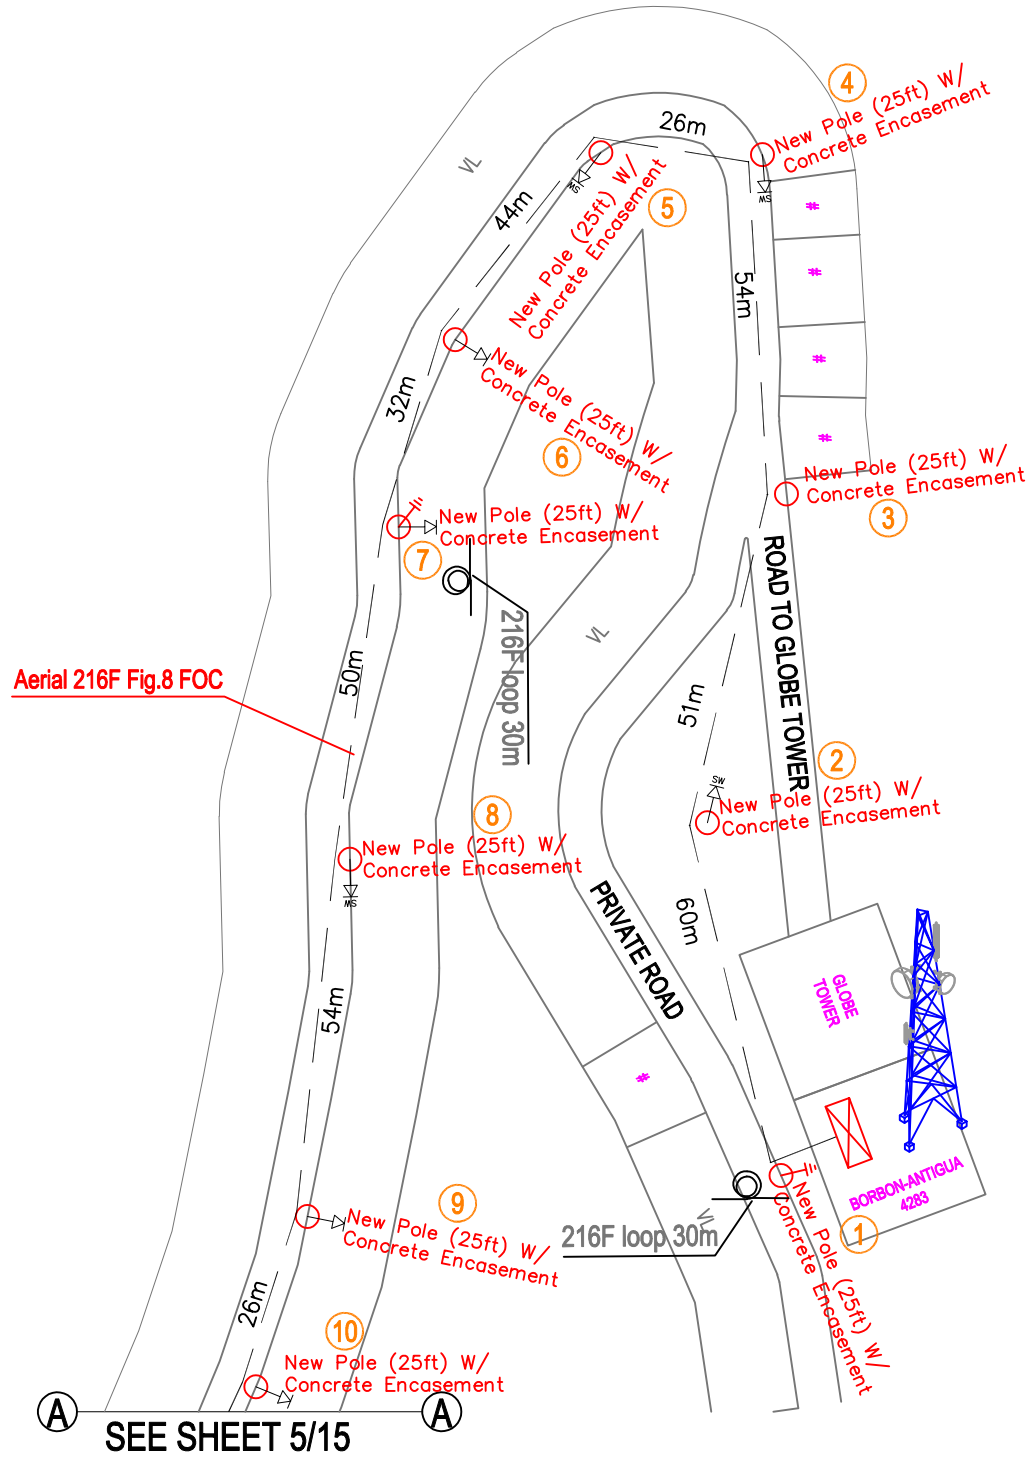

1


FEEDER AS BUILT PLAN		COA/CONTRACT			CONTRACTOR		VIS–CFAO TEAM			VISAYAS FIXED PROJECT MANAGEMENT TEAM			
	----	CONTRACT SCHEDULE:	SOW	CONTRACTED / ACTUAL	DRAWN BY:	CHECK BY:	NOTED BY:	NOTED BY:	APPROVED BY:	REVIEWED BY:	ENDORSED BY:	ACKNOWLEDGED BY:	SHEET
	WBS #:	ORIGINAL SCHED:	72F ODF	1 / 1									
	AS BUILT Of UPLINK–FEEDER	START:											
		COMPLETION:	216F CLOSURE	0 / 0									
		ACTUAL SCHED:											
		START:	72F CLOSURE	0 / 0									4/15
		COMPLETION:											
		ACCEPTANCE DATE:	NEW GROUNDING SYSTEM	1 / 2									
	EIM–HEAD						VisFFS3	Coordinator – VisFFS3	HEAD VisFFS	PROJECT ENGINEER	TEAM LEADER	DIVISION OPPM HEAD	DATE:

AS BUILT of UPLINK-FEEDER (5/15)

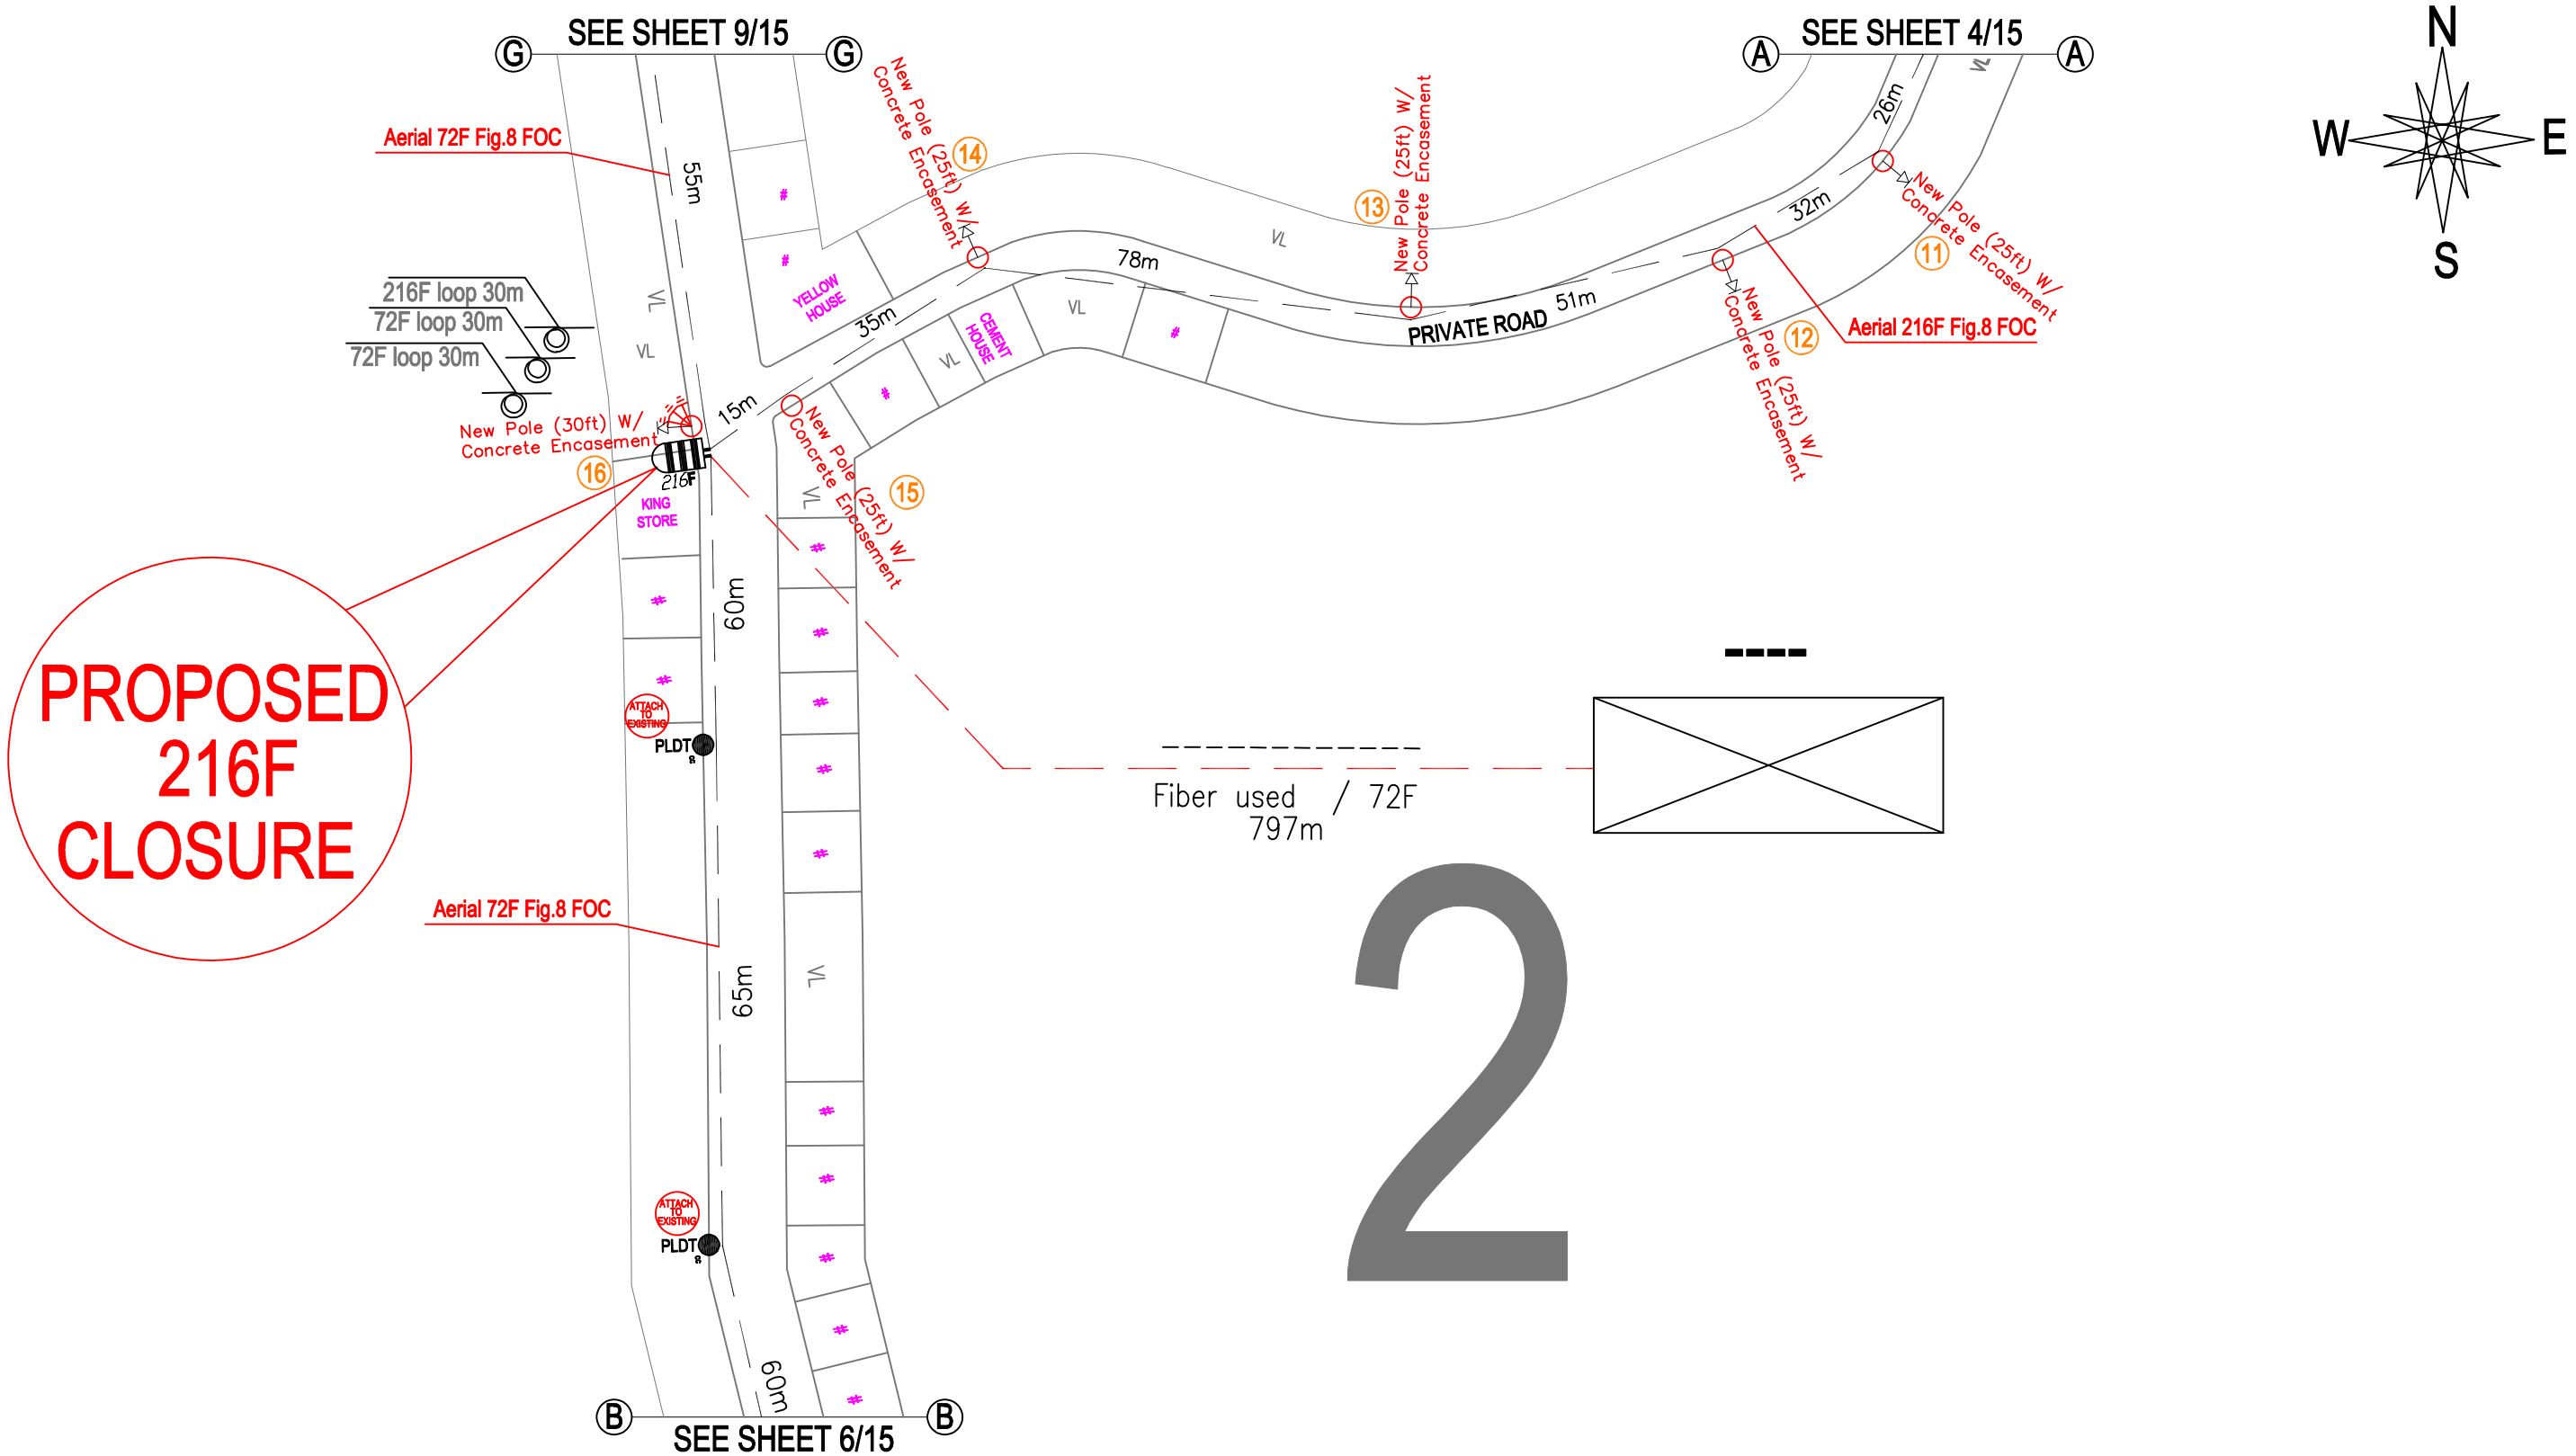


FEEDER AS BUILT PLAN		COA/CONTRACT				CONTRACTOR		VIS-CFAO TEAM			VISAYAS FIXED PROJECT MANAGEMENT TEAM			
	----	CONTRACT SCHEDULE:	SOW	CONTRACTED	ACTUAL	DRAWN BY:	CHECK BY:	NOTED BY:	NOTED BY:	APPROVED BY:	REVIEWED BY:	ENDORSED BY:	ACKNOWLEDGED BY:	SHEET
	WBS #:	ORIGINAL SCHED:	72F ODF	0	0									
	AS BUILT Of UPLINK-FEEDER	START:	216F CLOSURE	1	1									
		COMPLETION:	72F CLOSURE	0	0									5/15
		ACTUAL SCHED:	NEW GROUNDING SYSTEM	3	3									
		START:												
		COMPLETION:												
	EIM-HEAD	ACCEPTANCE DATE:						VisFFS3	Coordinator – VisFFS3	HEAD VisFFS	PROJECT ENGINEER	TEAM LEADER	DIVISION OPPM HEAD	DATE:


AS BUILT of UPLINK-FEEDER (6/15)

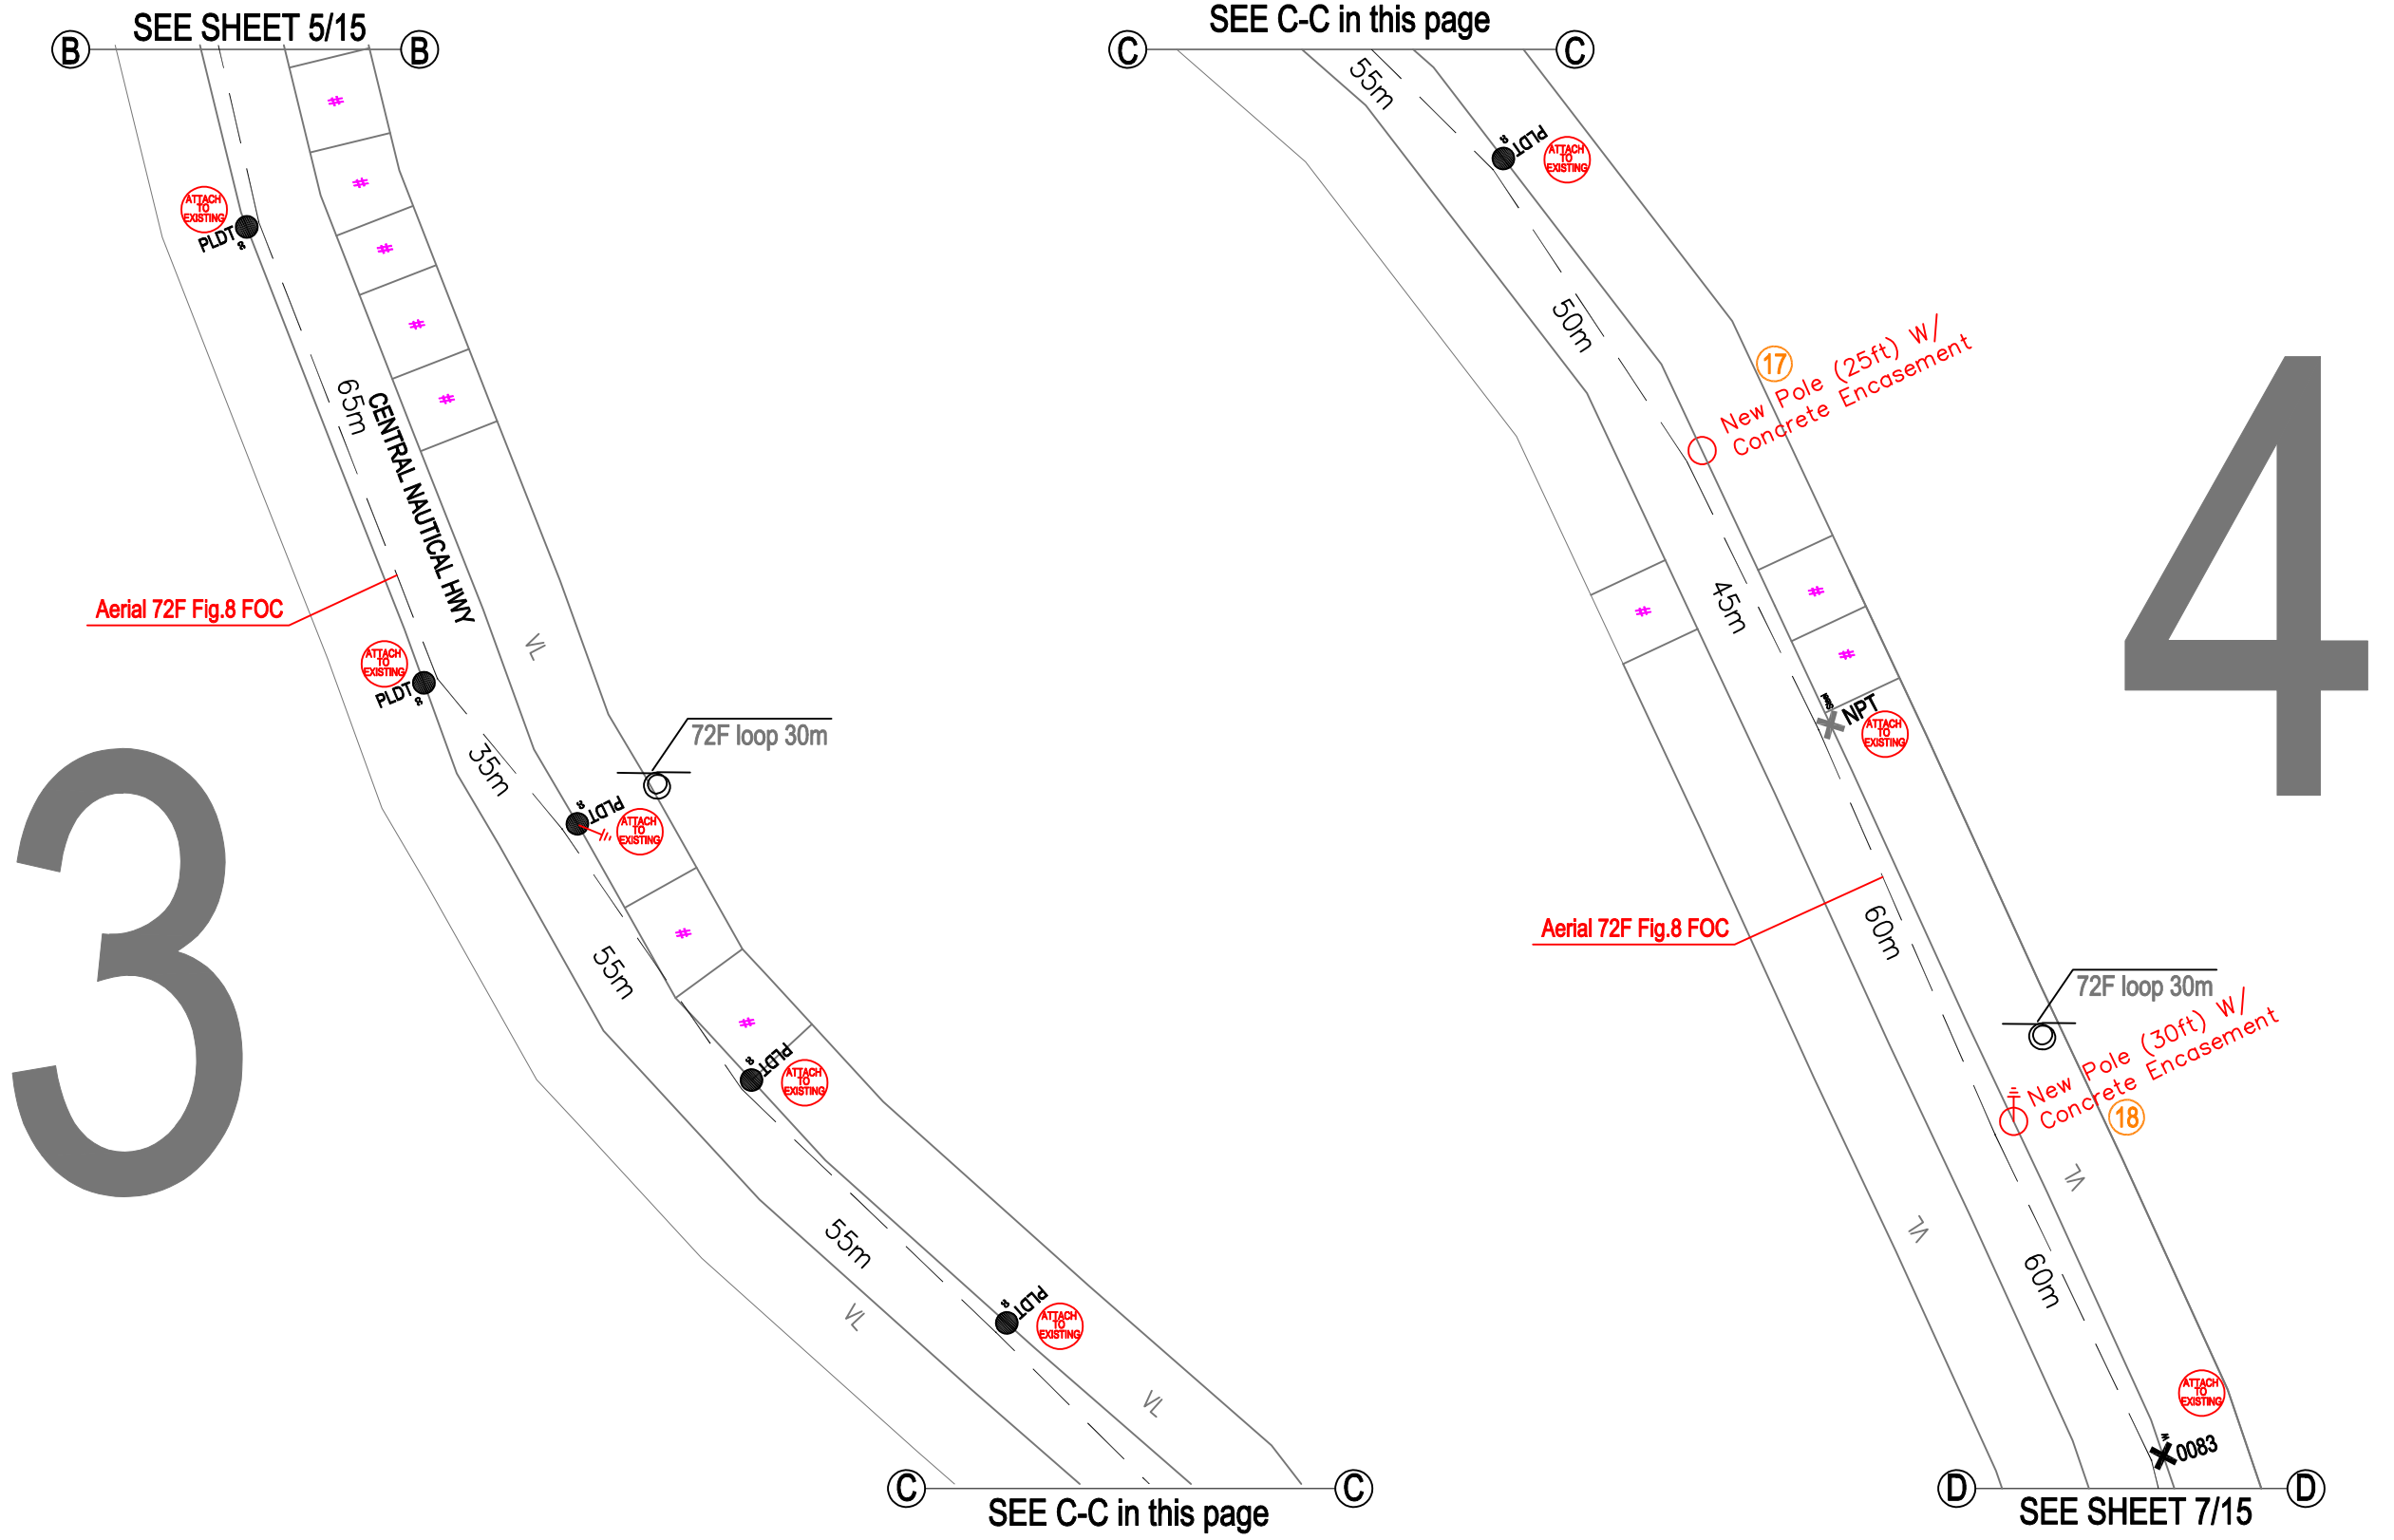


FEEDER AS BUILT PLAN		COA/CONTRACT			CONTRACTOR		VIS-CFAO TEAM			VISAYAS FIXED PROJECT MANAGEMENT TEAM			
	----	CONTRACT SCHEDULE:	SOW	CONTRACTED ACTUAL	DRAWN BY:	CHECK BY:	NOTED BY:	NOTED BY:	APPROVED BY:	REVIEWED BY:	ENDORSED BY:	ACKNOWLEDGED BY:	SHEET
	WBS #:	ORIGINAL SCHED:	72F ODF	0 0									
	AS BUILT Of UPLINK-FEEDER	START: COMPLETION:	216F CLOSURE	0 0									
		ACTUAL SCHED:	72F CLOSURE	0 0									6/15
		START: COMPLETION:	NEW GROUNDING SYSTEM	2 2									
	EIM-HEAD	ACCEPTANCE DATE:					VisFFS3	Coordinator - VisFFS3	HEAD VisFFS	PROJECT ENGINEER	TEAM LEADER	DIVISION OPPM HEAD	DATE:

AS BUILT of UPLINK-FEEDER (7/15)

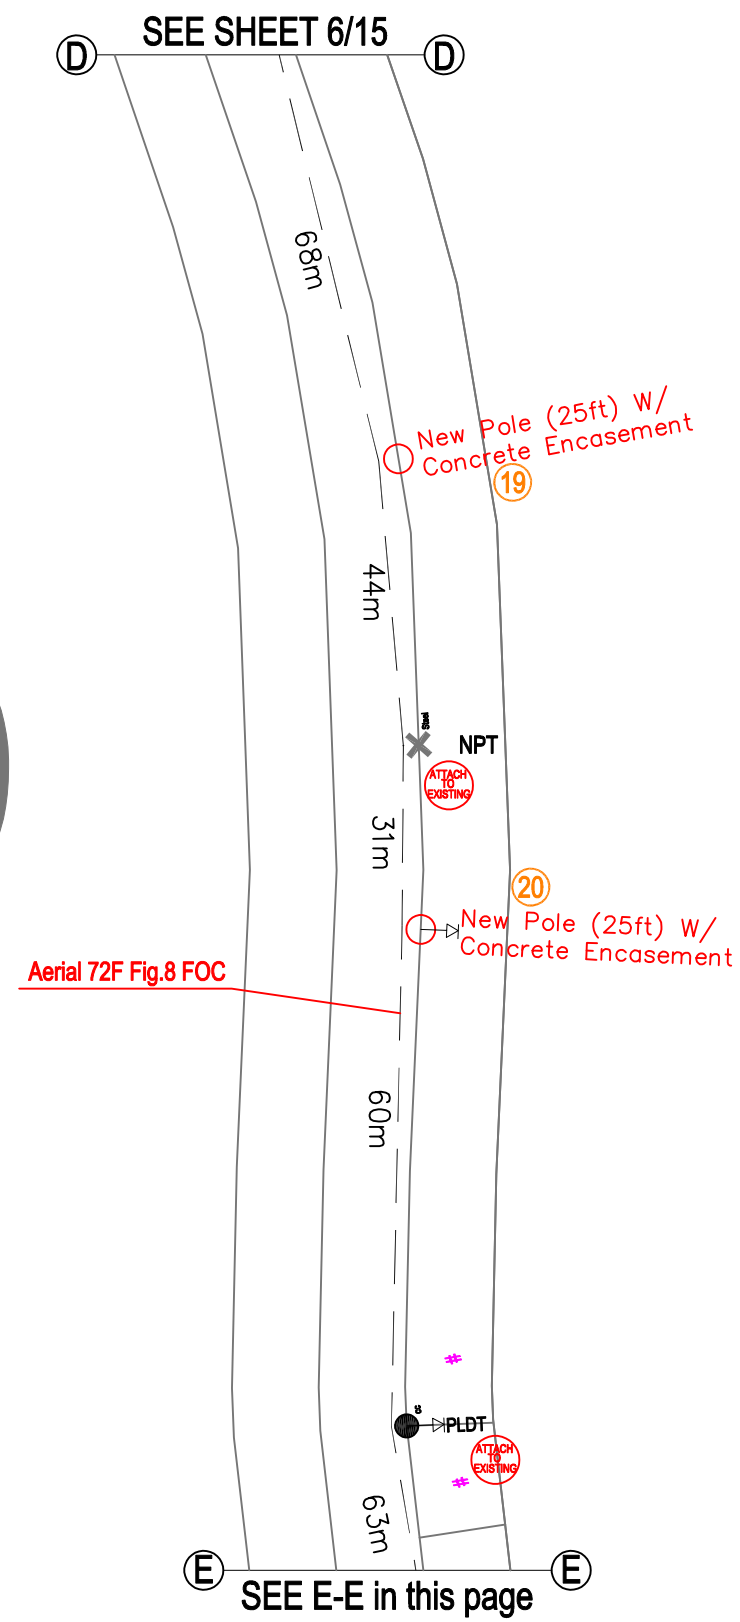

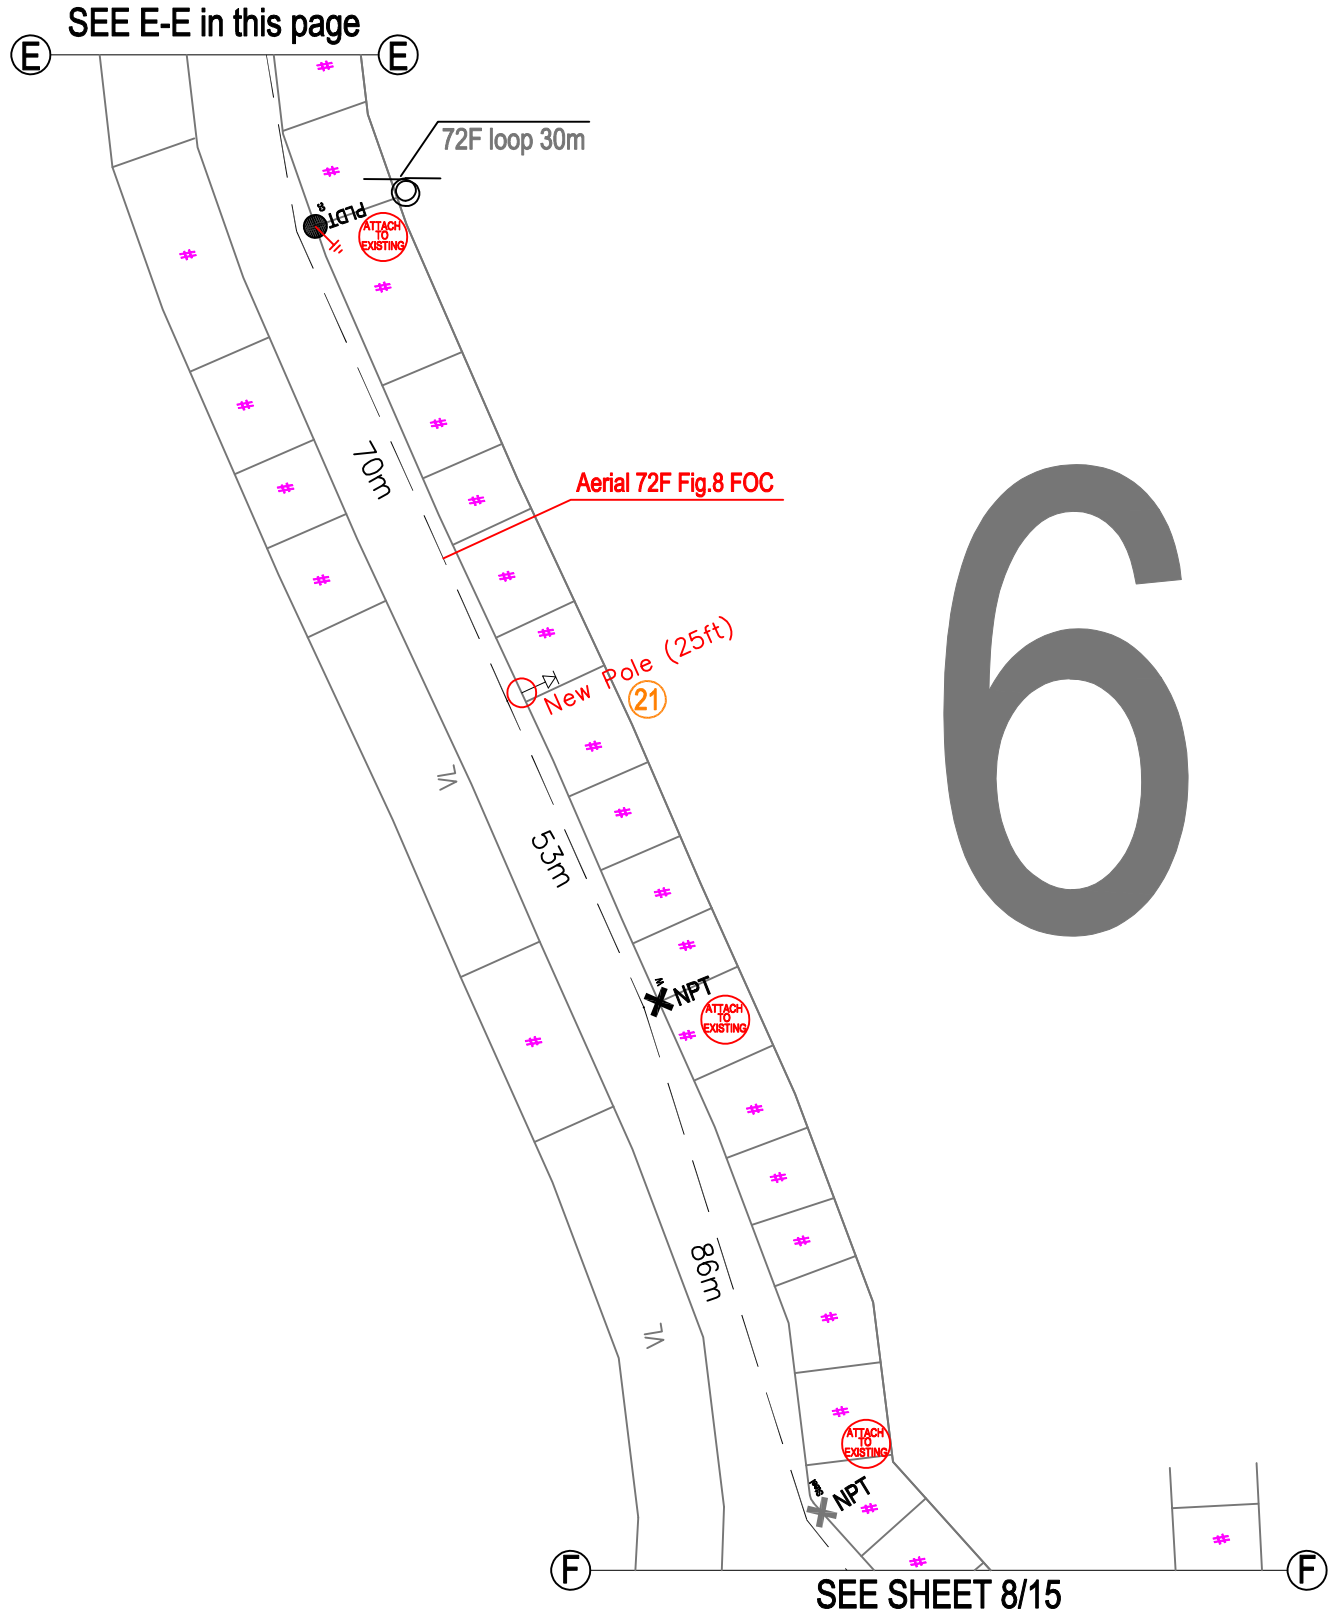

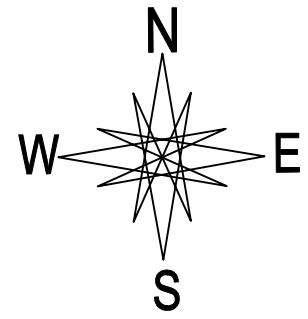

5


6

FEEDER AS BUILT PLAN		COA/CONTRACT			CONTRACTOR		VIS–CFAO TEAM			VISAYAS FIXED PROJECT MANAGEMENT TEAM			
	----	CONTRACT SCHEDULE:	SOW	CONTRACTED ACTUAL	DRAWN BY:	CHECK BY:	NOTED BY:	NOTED BY:	APPROVED BY:	REVIEWED BY:	ENDORSED BY:	ACKNOWLEDGED BY:	SHEET
	WBS #:	ORIGINAL SCHED:	72F ODF	0 0									
	AS BUILT Of UPLINK–FEEDER	START: COMPLETION:	216F CLOSURE	0 0									
		ACTUAL SCHED:	72F CLOSURE	0 0									7/15
	EIM–HEAD	START: COMPLETION: ACCEPTANCE DATE:	NEW GROUNDING SYSTEM	1 1			VisFFS3	Coordinator – VisFFS3	HEAD VisFFS	PROJECT ENGINEER	TEAM LEADER	DIVISION OPPM HEAD	DATE:

AS BUILT of UPLINK-FEEDER (8/15)


N
W E
S

7

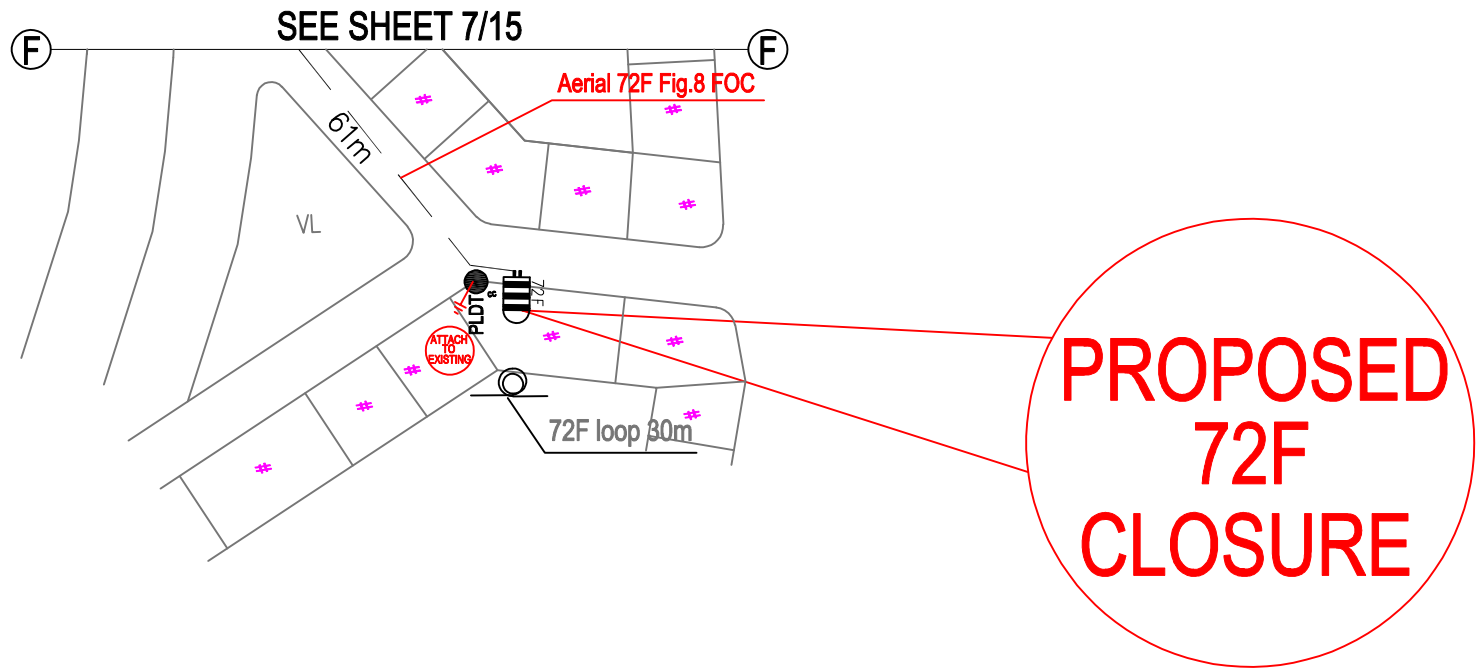


FEEDER AS BUILT PLAN		COA/CONTRACT			CONTRACTOR		VIS–CFAO TEAM			VISAYAS FIXED PROJECT MANAGEMENT TEAM			
	----	CONTRACT SCHEDULE:	SOW	CONTRACTED ACTUAL	DRAWN BY:	CHECK BY:	NOTED BY:	NOTED BY:	APPROVED BY:	REVIEWED BY:	ENDORSED BY:	ACKNOWLEDGED BY:	SHEET
	WBS #:	ORIGINAL SCHED:	72F ODF	0 0									
	AS BUILT Of UPLINK–FEEDER	START:											
		COMPLETION:	216F CLOSURE	0 0									
		ACTUAL SCHED:											
		START:	72F CLOSURE	1 1									8/15
		COMPLETION:											
		ACCEPTANCE DATE:	NEW GROUNDING SYSTEM	1 1									
	EIM–HEAD						VisFFS3	Coordinator – VisFFS3	HEAD VisFFS	PROJECT ENGINEER	TEAM LEADER	DIVISION OPPM HEAD	DATE:

AS BUILT of UPLINK-FEEDER (9/15)

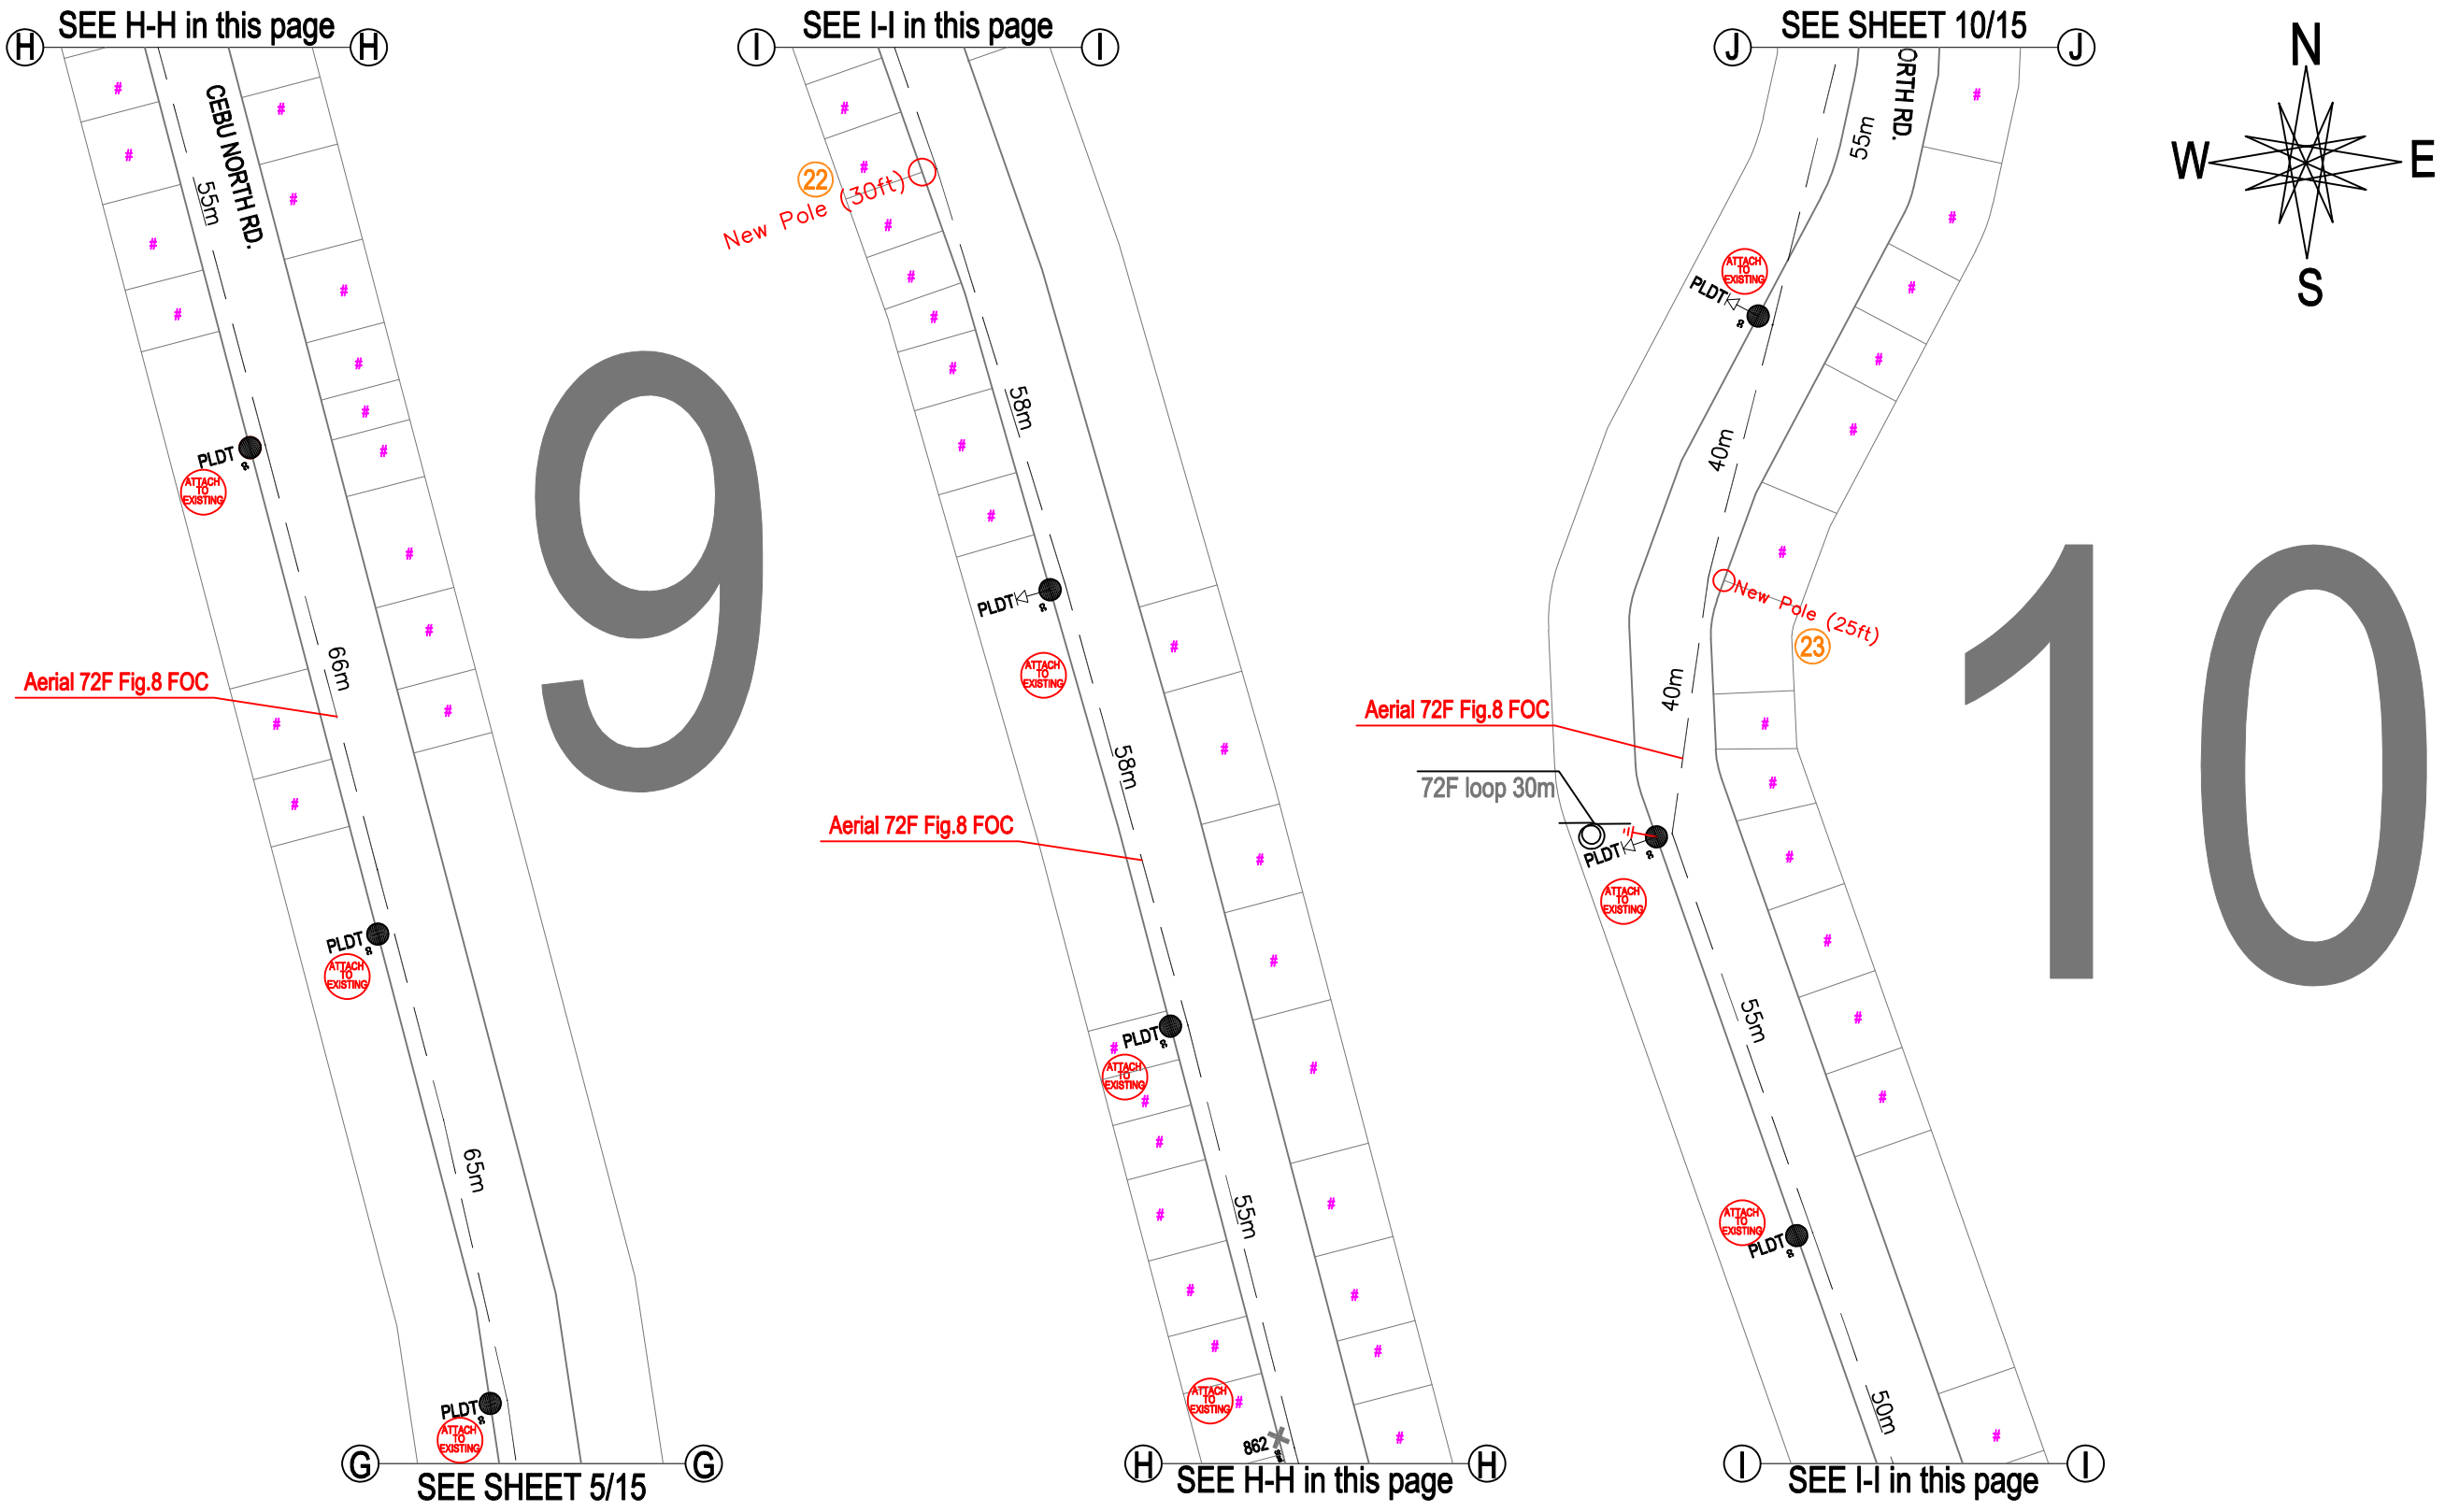

FEEDER AS BUILT PLAN		COA/CONTRACT			CONTRACTOR		VIS–CFAO TEAM			VISAYAS FIXED PROJECT MANAGEMENT TEAM			
	----	CONTRACT SCHEDULE:	SOW	CONTRACTED / ACTUAL	DRAWN BY:	CHECK BY:	NOTED BY:	NOTED BY:	APPROVED BY:	REVIEWED BY:	ENDORSED BY:	ACKNOWLEDGED BY:	SHEET
	WBS #:	ORIGINAL SCHED:	72F ODF	0 / 0									
	AS BUILT Of UPLINK–FEEDER	START:											
		COMPLETION:	216F CLOSURE	0 / 0									
		ACTUAL SCHED:											
		START:	72F CLOSURE	0 / 0									9/15
		COMPLETION:											
		ACCEPTANCE DATE:	NEW GROUNDING SYSTEM	2 / 1									
	EIM–HEAD						VisFFS3	Coordinator – VisFFS3	HEAD VisFFS	PROJECT ENGINEER	TEAM LEADER	DIVISION OPPM HEAD	DATE:


AS BUILT of UPLINK-FEEDER (10/15)

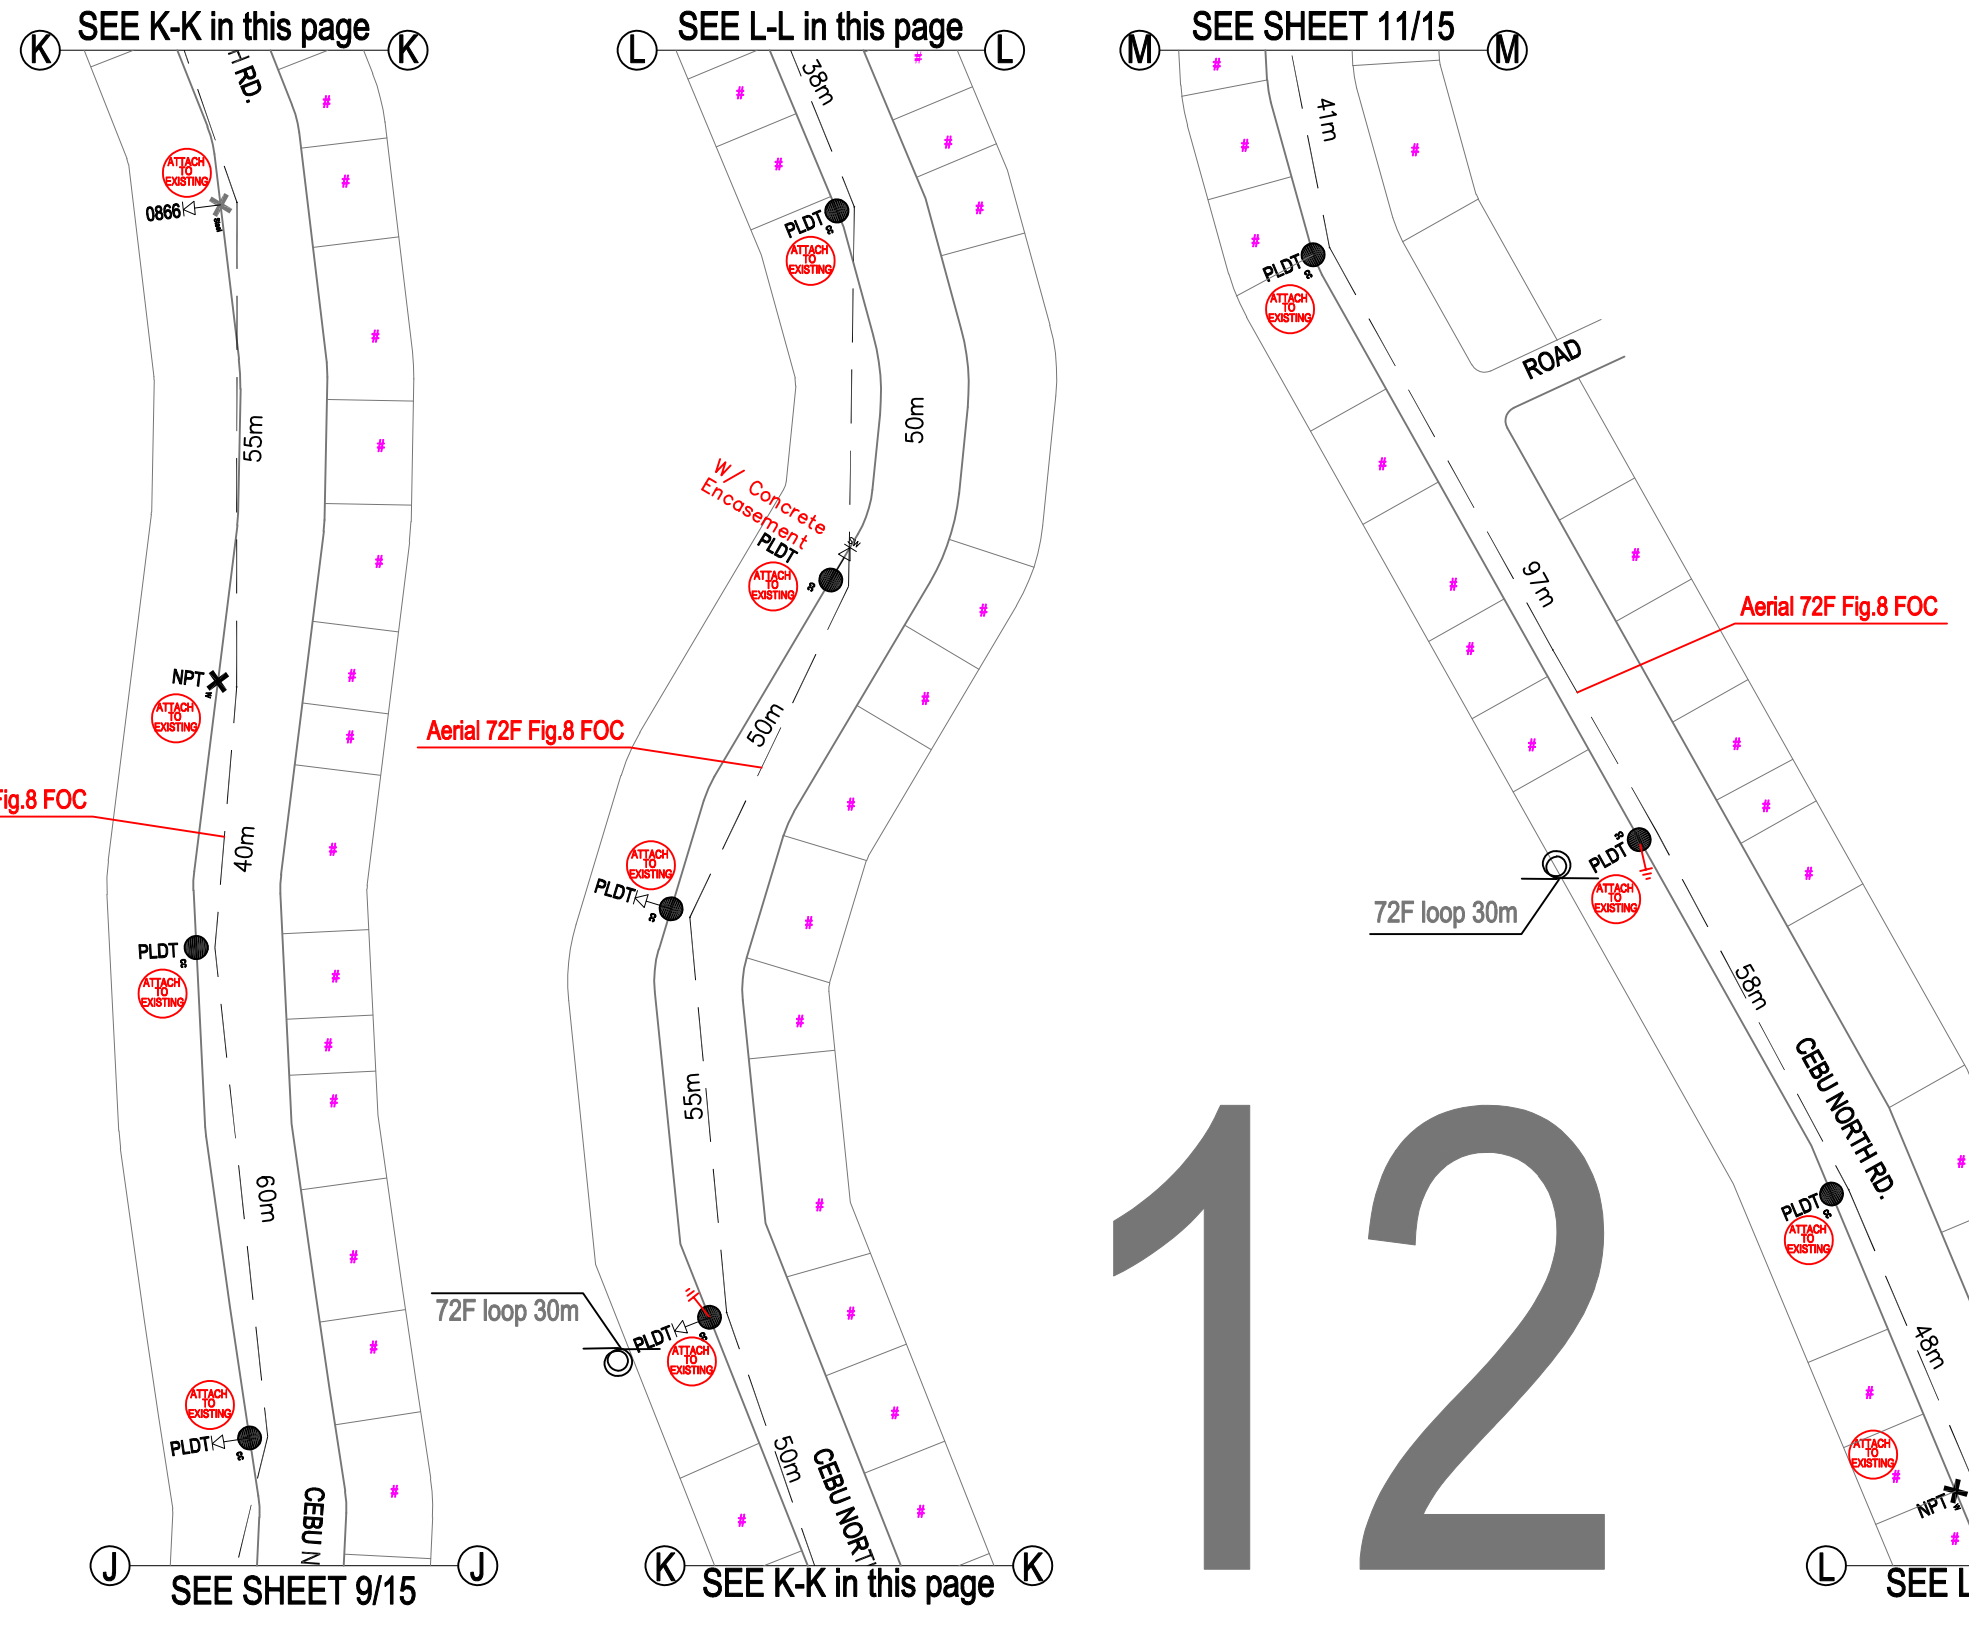



FEEDER AS BUILT PLAN		COA/CONTRACT			CONTRACTOR		VIS–CFAO TEAM			VISAYAS FIXED PROJECT MANAGEMENT TEAM			
	----	CONTRACT SCHEDULE:	SOW	CONTRACTED ACTUAL	DRAWN BY:	CHECK BY:	NOTED BY:	NOTED BY:	APPROVED BY:	REVIEWED BY:	ENDORSED BY:	ACKNOWLEDGED BY:	SHEET
	WBS #:	ORIGINAL SCHED:	72F ODF	0 0									
	AS BUILT Of UPLINK–FEEDER	START:	216F CLOSURE	0 0									
		COMPLETION:	72F CLOSURE	0 0									10/15
		ACTUAL SCHED:	NEW GROUNDING SYSTEM	2 2									
		START:											
		COMPLETION:											
	EIM–HEAD	ACCEPTANCE DATE:					VisFFS3	Coordinator – VisFFS3	HEAD VisFFS	PROJECT ENGINEER	TEAM LEADER	DIVISION OPPM HEAD	DATE:

AS BUILT of UPLINK-FEEDER (11/15)

14

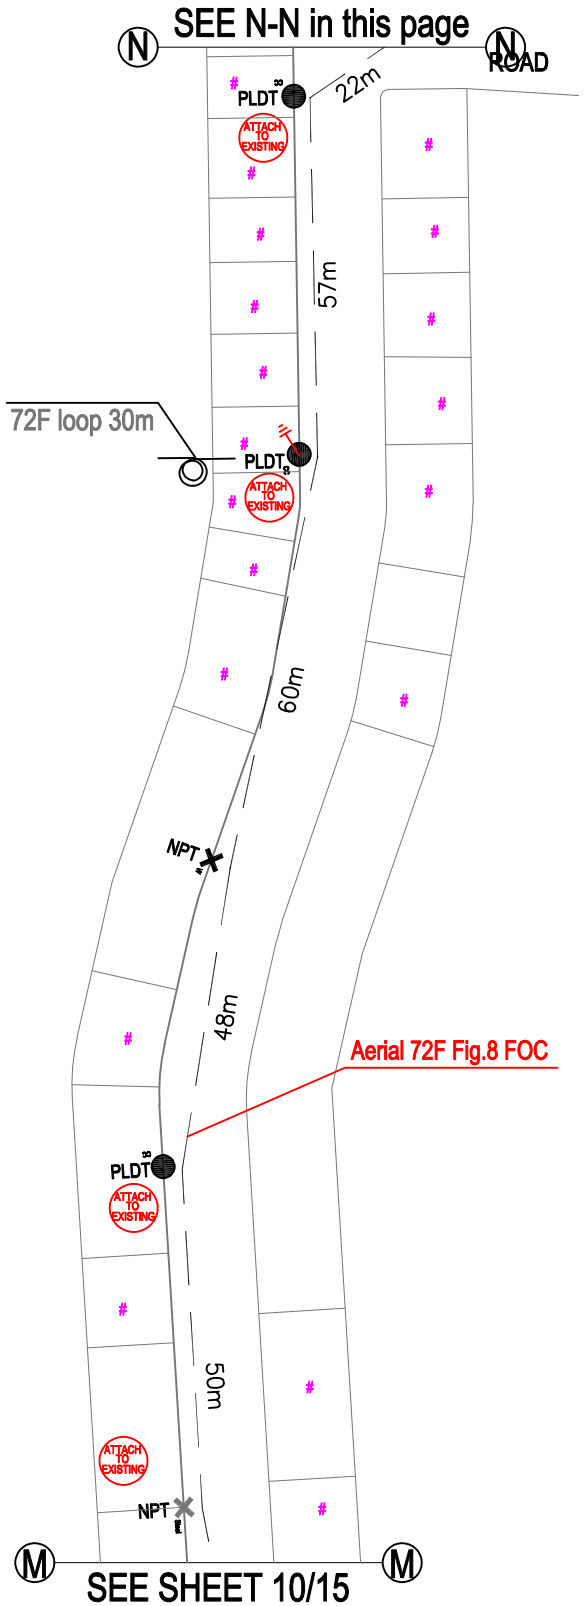

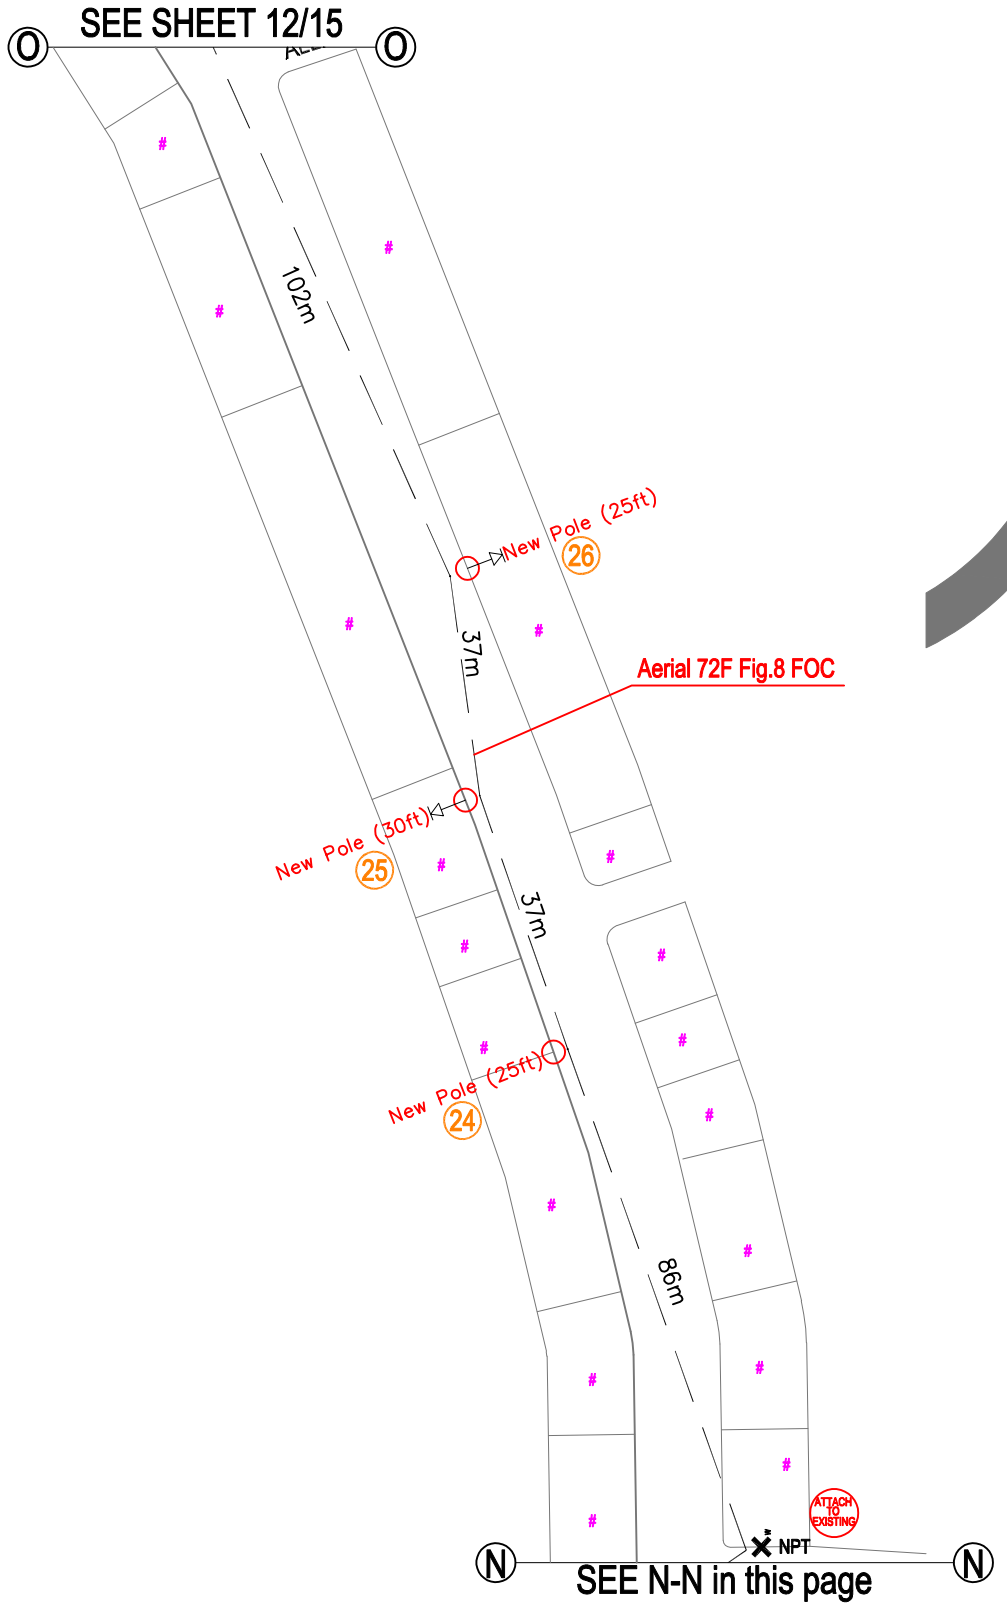


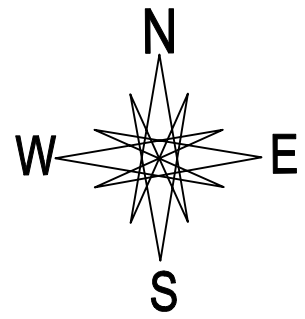

15

FEEDER AS BUILT PLAN		COA/CONTRACT			CONTRACTOR		VIS–CFAO TEAM			VISAYAS FIXED PROJECT MANAGEMENT TEAM			
	----	CONTRACT SCHEDULE:	SOW	CONTRACTED / ACTUAL	DRAWN BY:	CHECK BY:	NOTED BY:	NOTED BY:	APPROVED BY:	REVIEWED BY:	ENDORSED BY:	ACKNOWLEDGED BY:	SHEET
	WBS #:	ORIGINAL SCHED: START: COMPLETION:	72F ODF	0 / 0									
	AS BUILT Of UPLINK–FEEDER	ACTUAL SCHED: START: COMPLETION:	216F CLOSURE	0 / 0									
			72F CLOSURE	0 / 0									
	EIM–HEAD	ACCEPTANCE DATE:	NEW GROUNDING SYSTEM	1 / 1			VisFFS3	Coordinator – VisFFS3	HEAD VisFFS	PROJECT ENGINEER	TEAM LEADER	DIVISION OPPM HEAD	11/15 DATE:


AS BUILT of UPLINK-FEEDER (12/15)

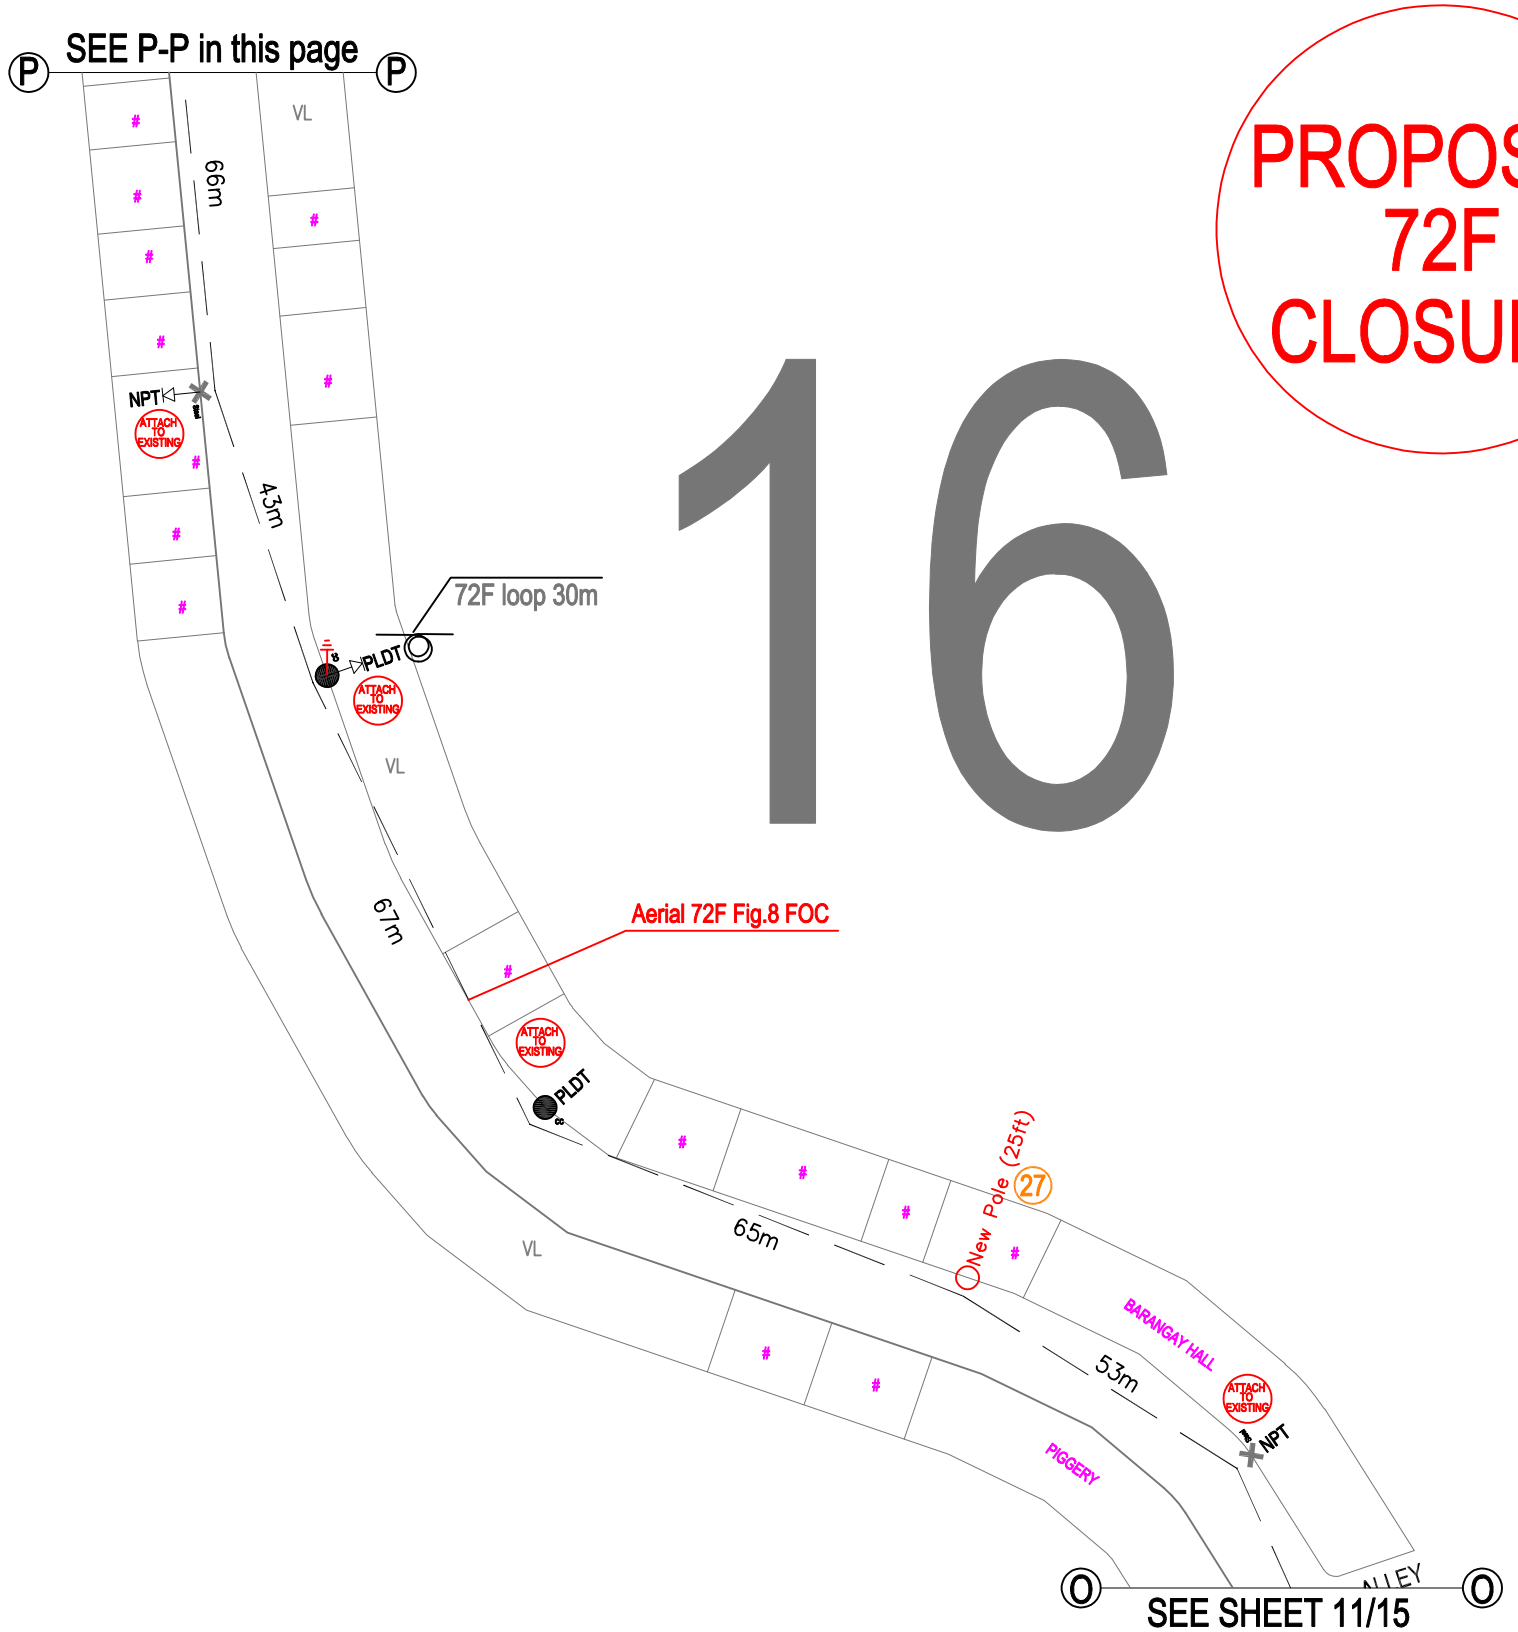


16

PROPOSED 72F CLOSURE

17

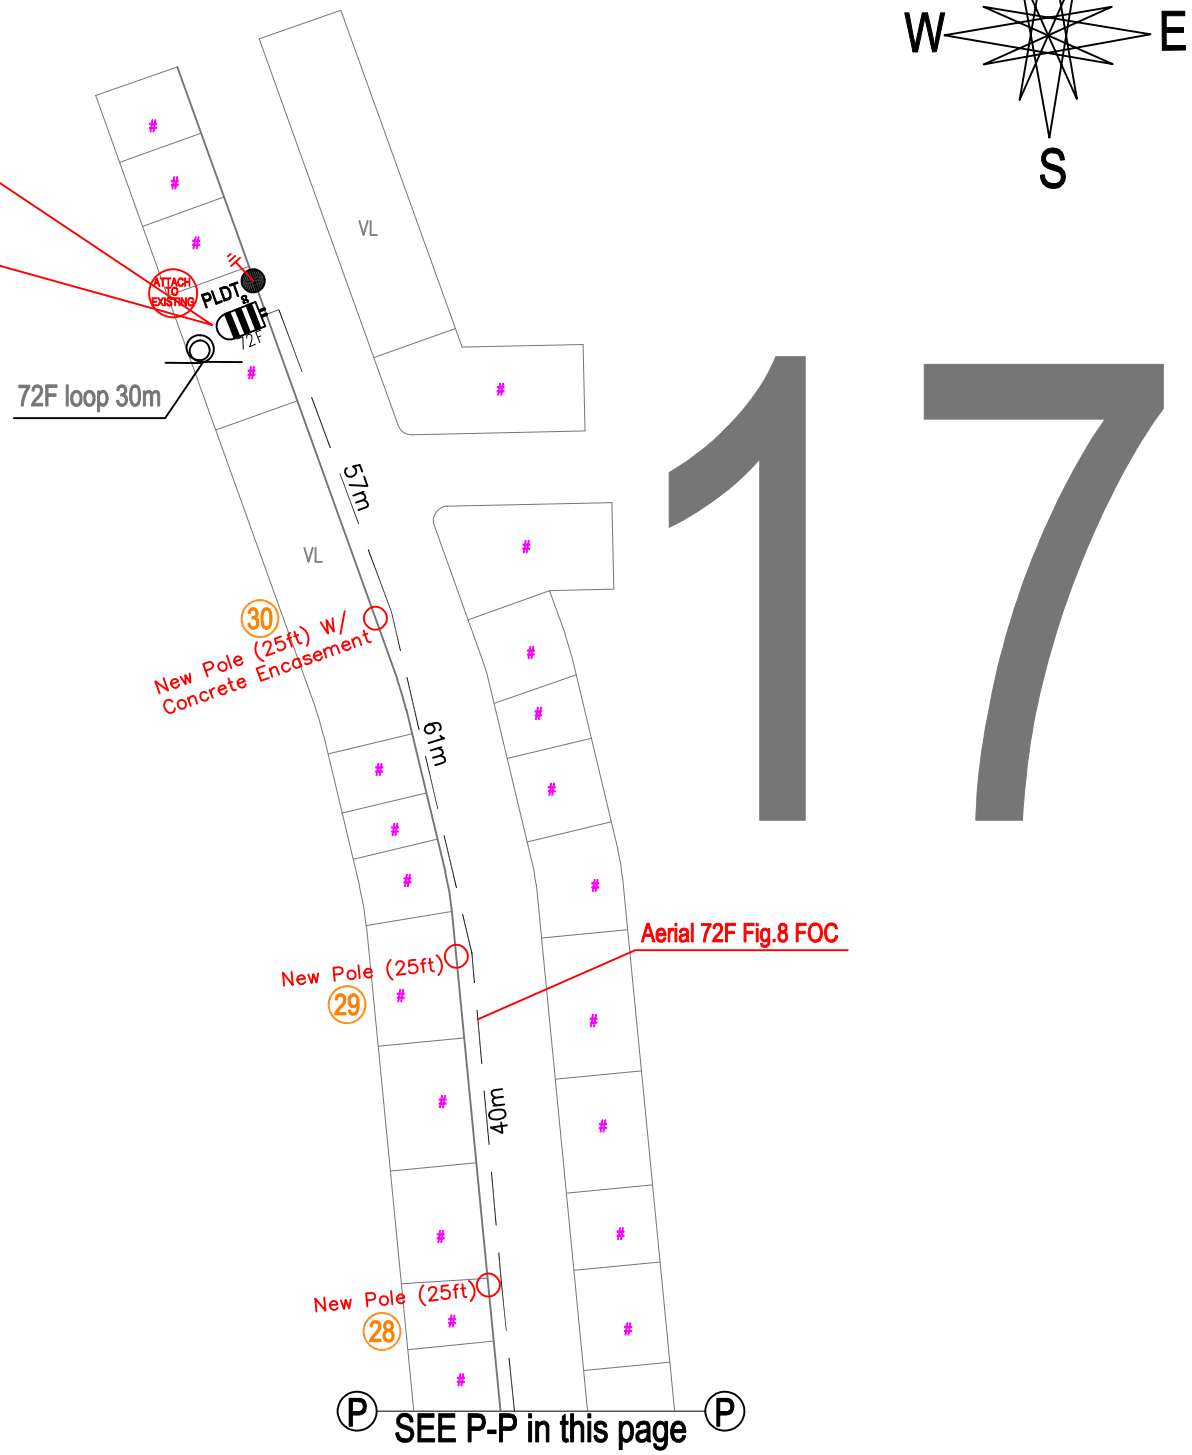


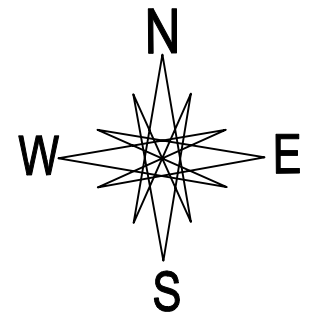

FEEDER AS BUILT PLAN		COA/CONTRACT			CONTRACTOR		VIS-CFAO TEAM			VISAYAS FIXED PROJECT MANAGEMENT TEAM			
	----	CONTRACT SCHEDULE:	SOW	CONTRACTED ACTUAL	DRAWN BY:	CHECK BY:	NOTED BY:	NOTED BY:	APPROVED BY:	REVIEWED BY:	ENDORSED BY:	ACKNOWLEDGED BY:	SHEET
	WBS #:	ORIGINAL SCHED:	72F ODF	0 0									
	AS BUILT Of UPLINK-FEEDER	START:											
		COMPLETION:	216F CLOSURE	0 0									
		ACTUAL SCHED:											
		START:	72F CLOSURE	1 1									12/15
		COMPLETION:											
		ACCEPTANCE DATE:	NEW GROUNDING SYSTEM	3 2									
	EIM-HEAD						VisFFS3	Coordinator - VisFFS3	HEAD VisFFS	PROJECT ENGINEER	TEAM LEADER	DIVISION OPPM HEAD	DATE:

AS BUILT of UPLINK-FEEDER (13/15)

FEEDER CEF

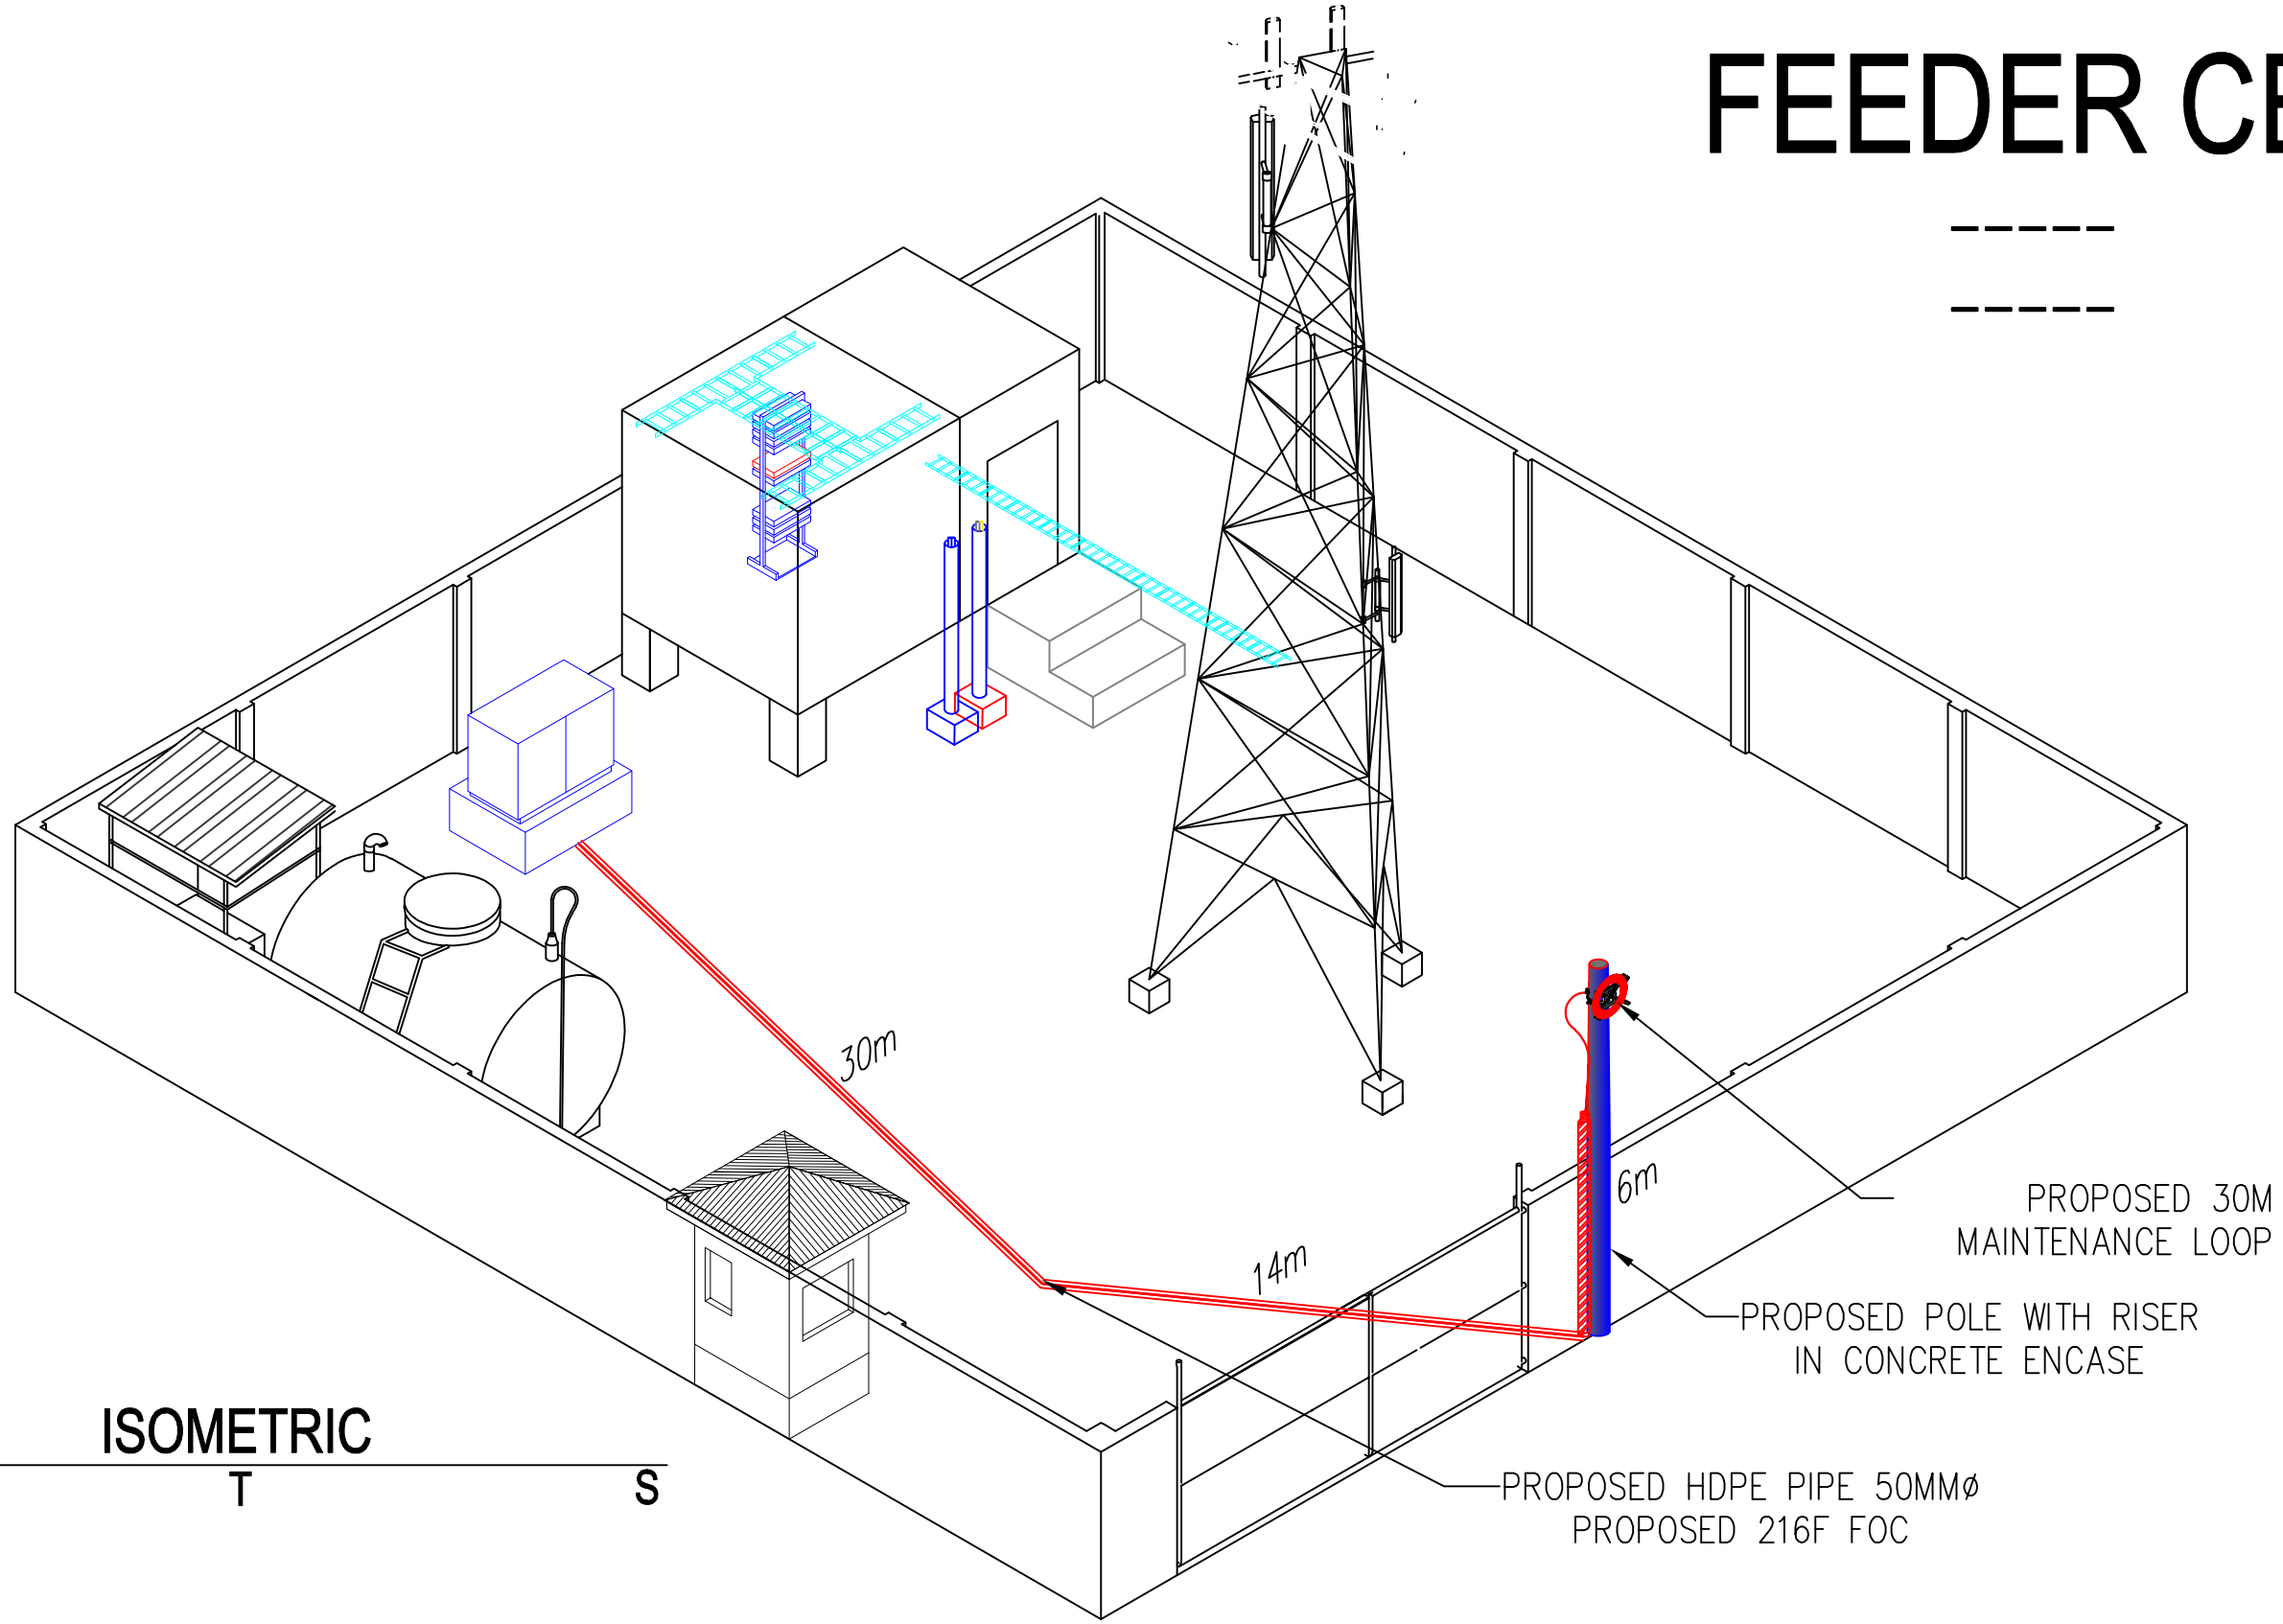


ISOMETRIC

N T S

FEEDER PROPOSED PLAN		COA/CONTRACT			CONTRACTOR		VisFFS TEAM			FIXED ACCESS ENGINEERING TEAM			
	----	CONTRACT SCHEDULE:	SOW	CONTRACTED ACTUAL	DRAWN BY:	CHECK BY:	CERTIFIED BY:	CERTIFIED BY:	APPROVED BY:	REVIEWED BY:	ENDORSED BY:	ACKNOWLEDGED BY:	SHEET
	WBS #:	ORIGINAL SCHED:	72F ODF	1									
	AS BUILT Of UPLINK-FEEDER	START:											
		COMPLETION:	216F CLOSURE	1									
		ACTUAL SCHED:											
		START:	72F CLOSURE	2									
		COMPLETION:											
		ACCEPTANCE DATE:	NEW GROUNDING SYSTEM	16									
	EIM-HEAD						VisFFS3	Coordinator-VisFFS3	HEAD VisFFS				13/15
													DATE:

AS BUILT of UPLINK-FEEDER (14/15)

UPLINK CEF

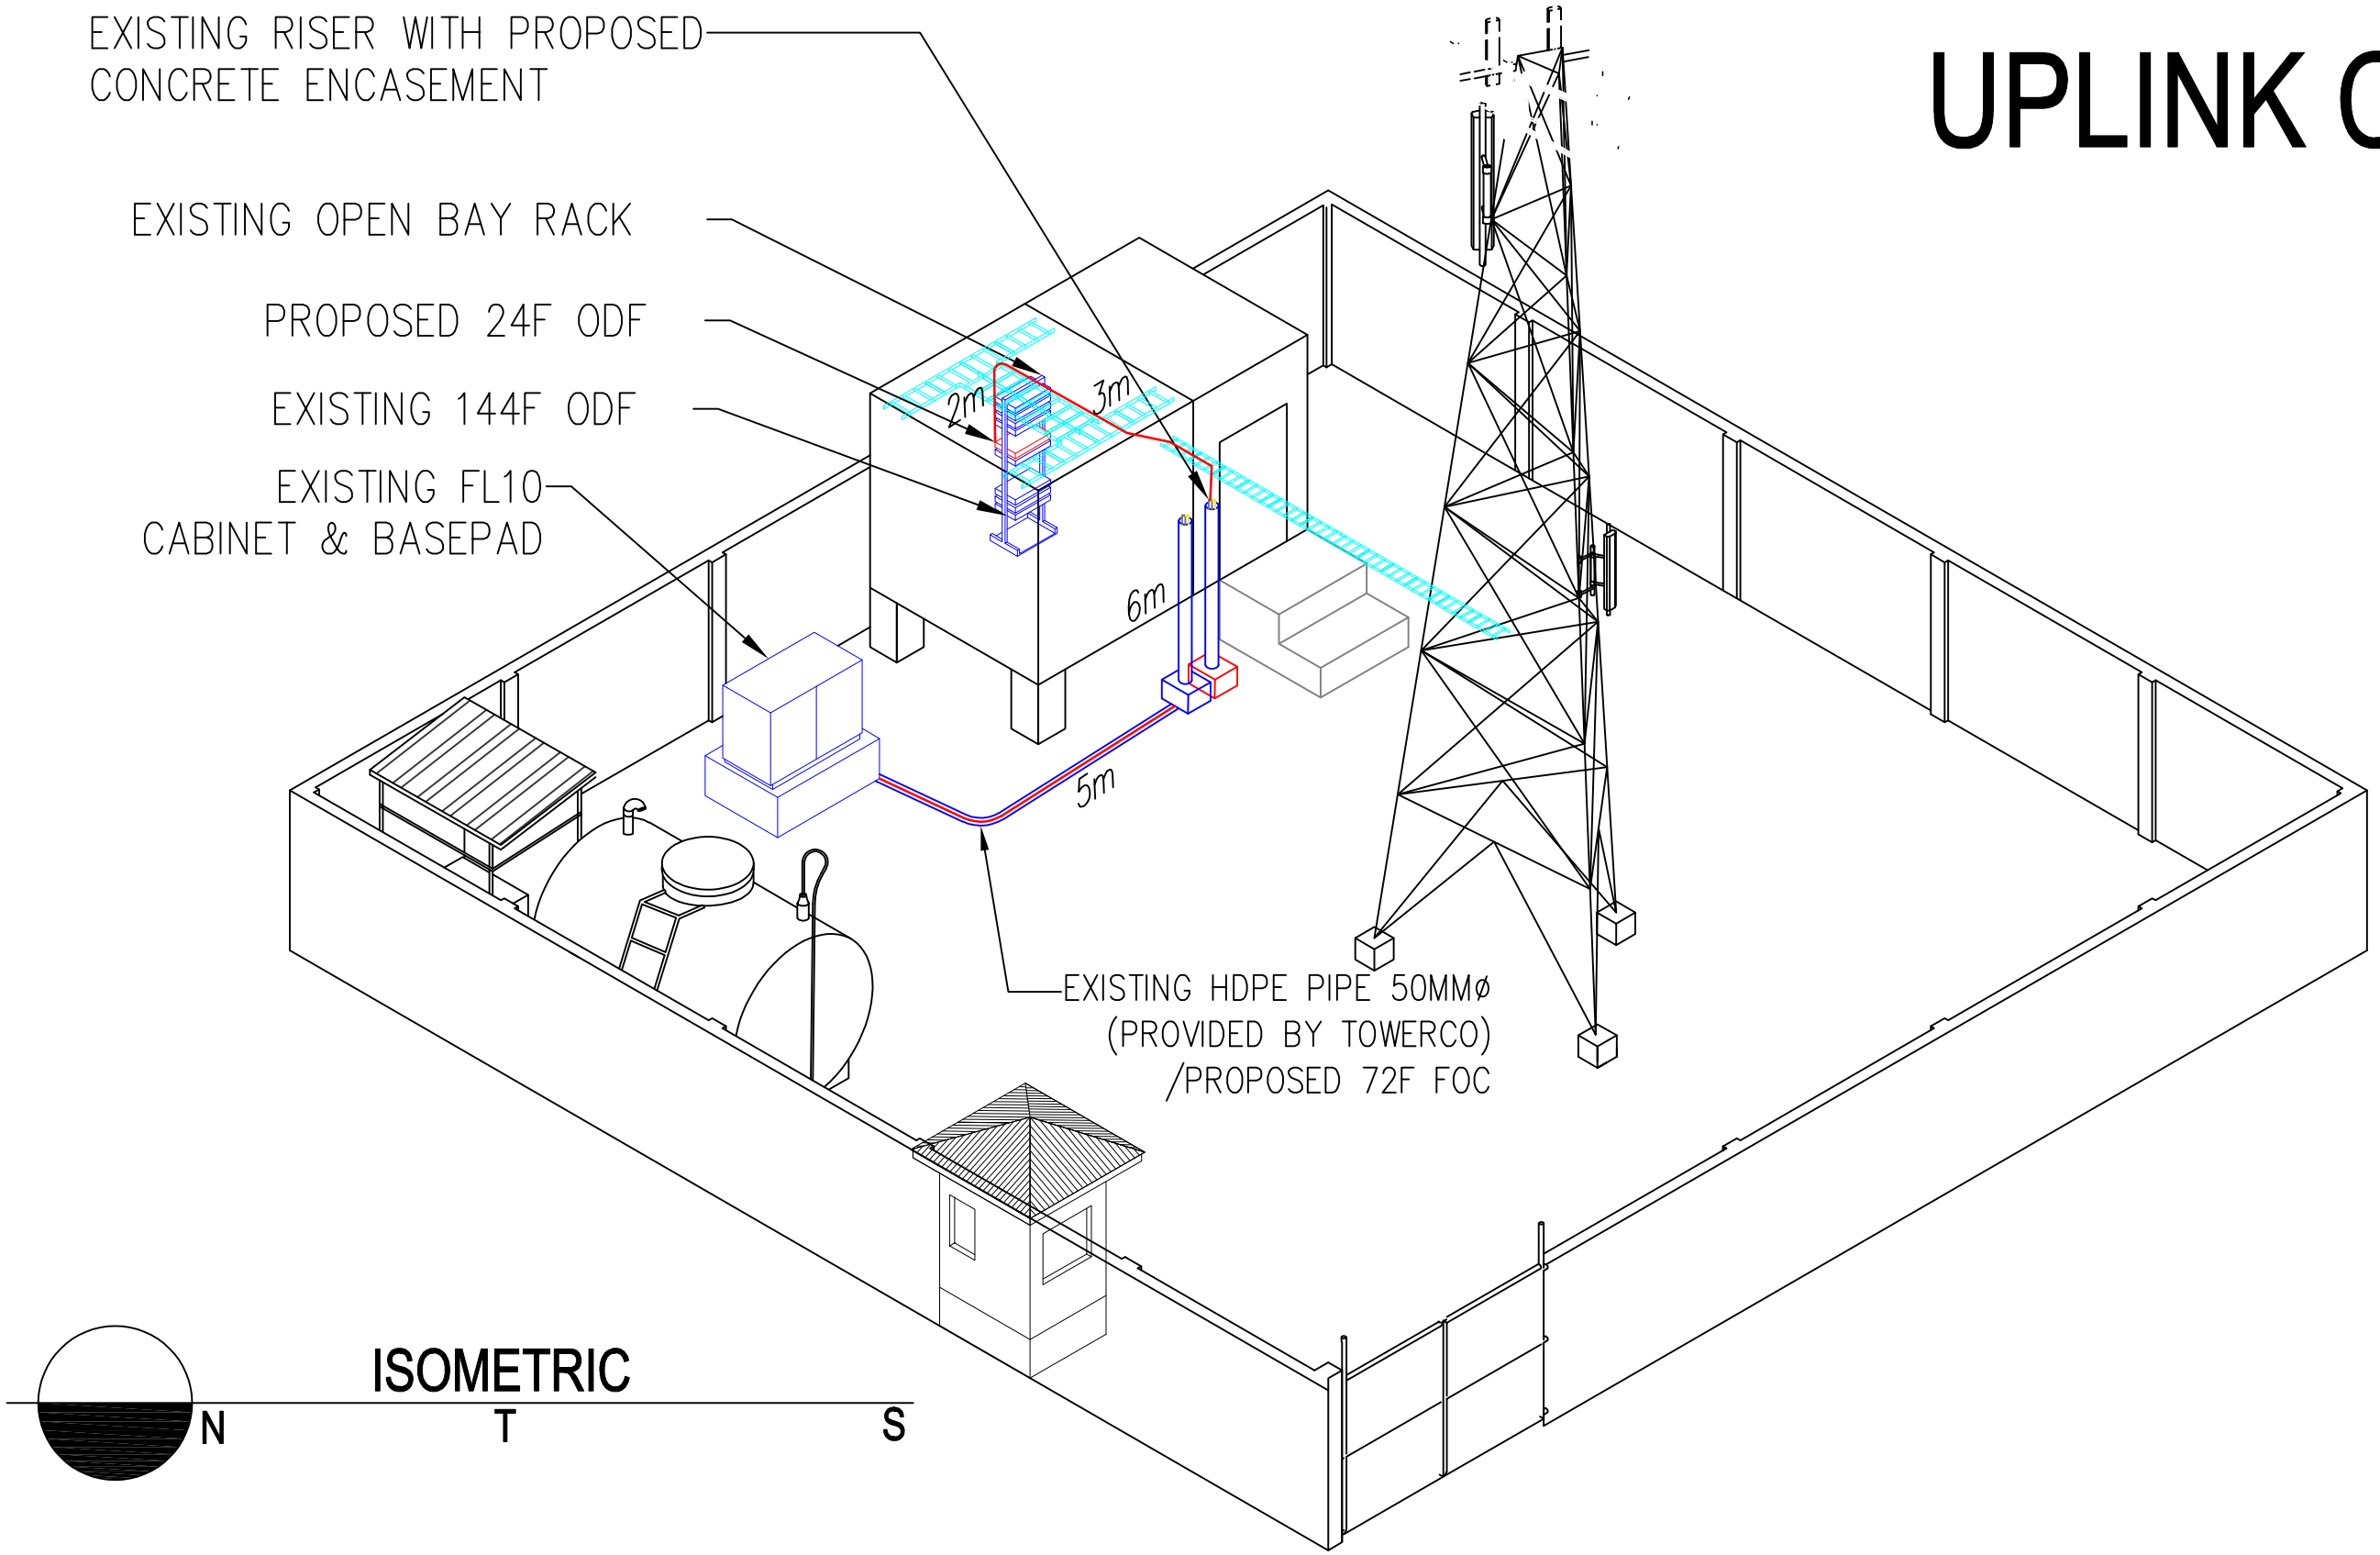


ISOMETRIC

N T S

FEEDER PROPOSED PLAN		COA/CONTRACT			CONTRACTOR		VisFFS TEAM			FIXED ACCESS ENGINEERING TEAM			
	----	CONTRACT SCHEDULE:	SOW	CONTRACTED ACTUAL	DRAWN BY:	CHECK BY:	CERTIFIED BY:	CERTIFIED BY:	APPROVED BY:	REVIEWED BY:	ENDORSED BY:	ACKNOWLEDGED BY:	SHEET
	WBS #:	ORIGINAL SCHED:	72F ODF	1									
	AS BUILT Of UPLINK-FEEDER	START:											
		COMPLETION:	216F CLOSURE	1									
		ACTUAL SCHED:											
		START:	72F CLOSURE	2									
		COMPLETION:											
		ACCEPTANCE DATE:	NEW GROUNDING SYSTEM	16									
	EIM-HEAD						VisFFS3	Coordinator-VisFFS3	HEAD VisFFS				14/15
													DATE:

AS BUILT of UPLINK-FEEDER (15/15)

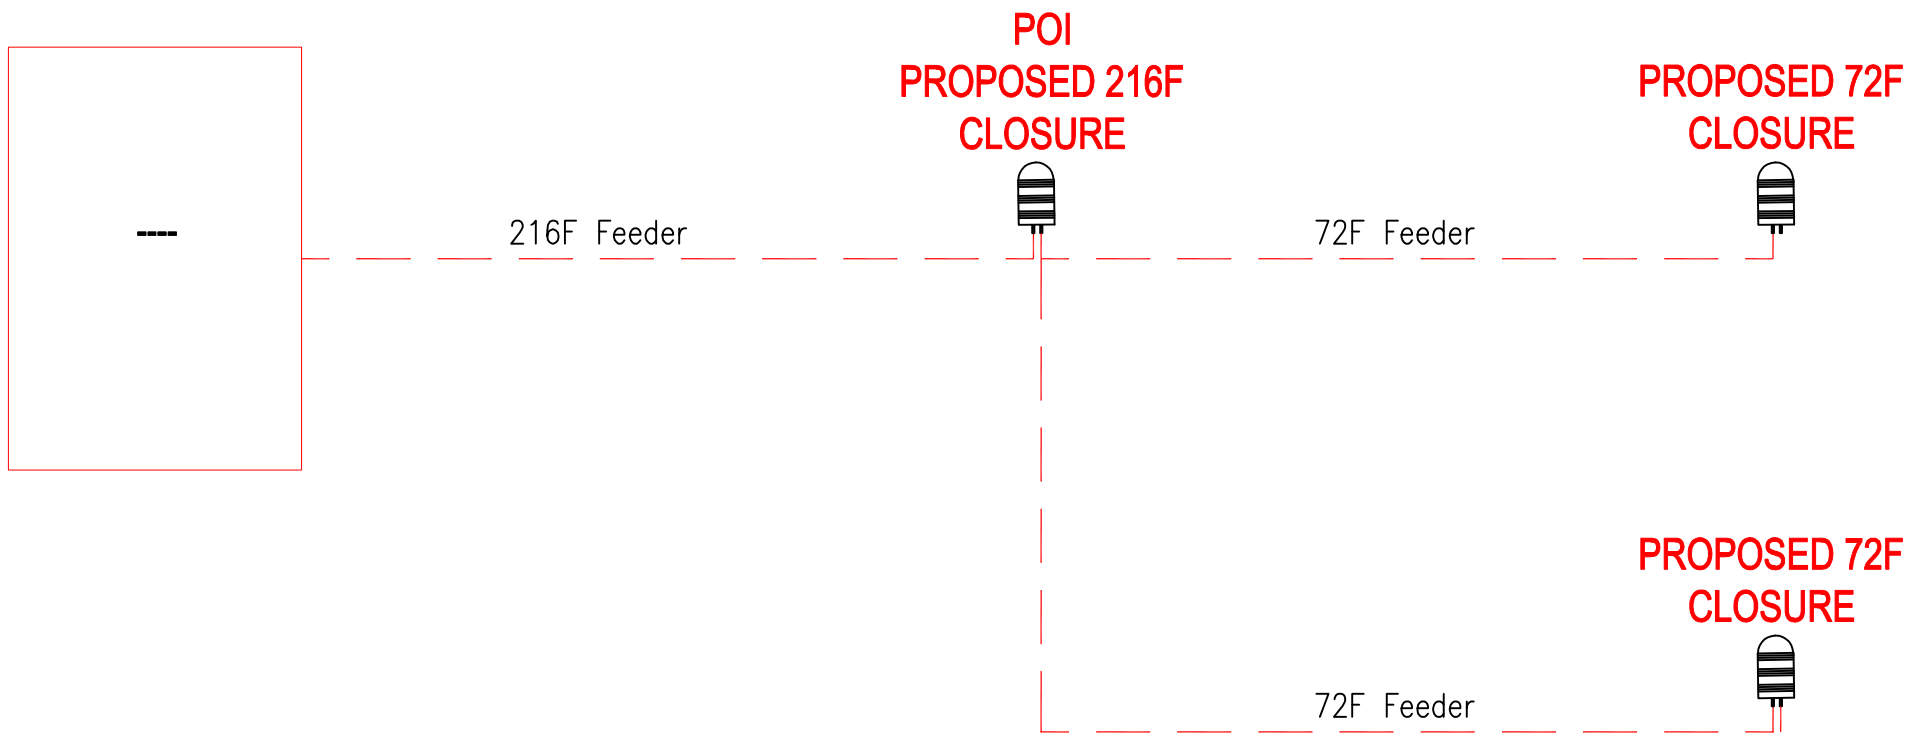

FEEDER AS BUILT PLAN		COA/CONTRACT				CONTRACTOR		VIS-CFAO TEAM			VISAYAS FIXED PROJECT MANAGEMENT TEAM			
	----	CONTRACT SCHEDULE:	SOW	CONTRACTED	ACTUAL	DRAWN BY:	CHECK BY:	NOTED BY:	NOTED BY:	APPROVED BY:	REVIEWED BY:	ENDORSED BY:	ACKNOWLEDGED BY:	SHEET
	WBS #:	ORIGINAL SCHED:	72F ODF	1	1									
	AS BUILT Of UPLINK-FEEDER	START:												
		COMPLETION:	216F CLOSURE	1	1									
		ACTUAL SCHED:												
		START:	72F CLOSURE	2	2									15/15
		COMPLETION:												
		ACCEPTANCE DATE:	NEW GROUNDING SYSTEM	16	14									
	EIM-HEAD							VisFFS3	Coordinator – VisFFS3	HEAD VisFFS	PROJECT ENGINEER	TEAM LEADER	DIVISION OPPM HEAD	DATE: